
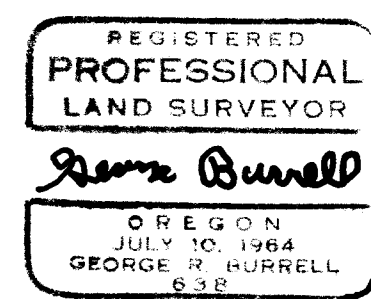


SCALE 1" = 300'

Basis of Bearings Solar Observation

LEGEND

- ⊙ = Fd. 2" I. Pipe w/3" br. disc (B.L.M.)
- = Set 5/8" x 30" Iron Pin

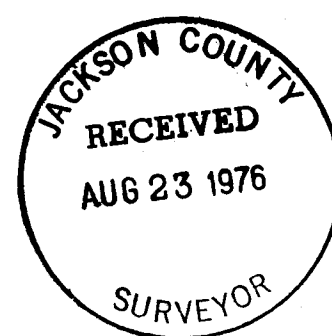

MAP OF SURVEY

Located in Section 12, Twp 38S, R 3E
 For: ROGER WEISS, CENTRAL POINT
 By: George Burrell, Surveyor, July 1976

SURVEY NO. 6443

SURVEY NARRATIVE TO COMPLY WITH O.R.S. 209.250

FOR: Roger Weiss
6175 Ventura Ln.
Central Point, Oregon

PURPOSE: To monument seven tracts described in land contracts
of record, as shown on the accompanying map.

PURPOSE: All corners controlling the subdivision of section 12
were traversed to through closed traverses utilizing
a 20" Franke Theodilite and a H.P. 3805 distance meter.
B.L.M. exterior 1/16 corners found were held inasmuch
as they fall within the required precision for B.L.M.
The fractional interior corners were then calc. and
monumented as shown on the accompanying map. As Dead
Indian County Road was not established by this survey,
witness corners were set accordingly.

REGISTERED
PROFESSIONAL
LAND SURVEYOR

George Burrell

OREGON
JULY 10, 1964
GEORGE R. BURRELL
638

JACKSON COUNTY
RECEIVED
AUG 23 1976
SURVEYOR