


6483

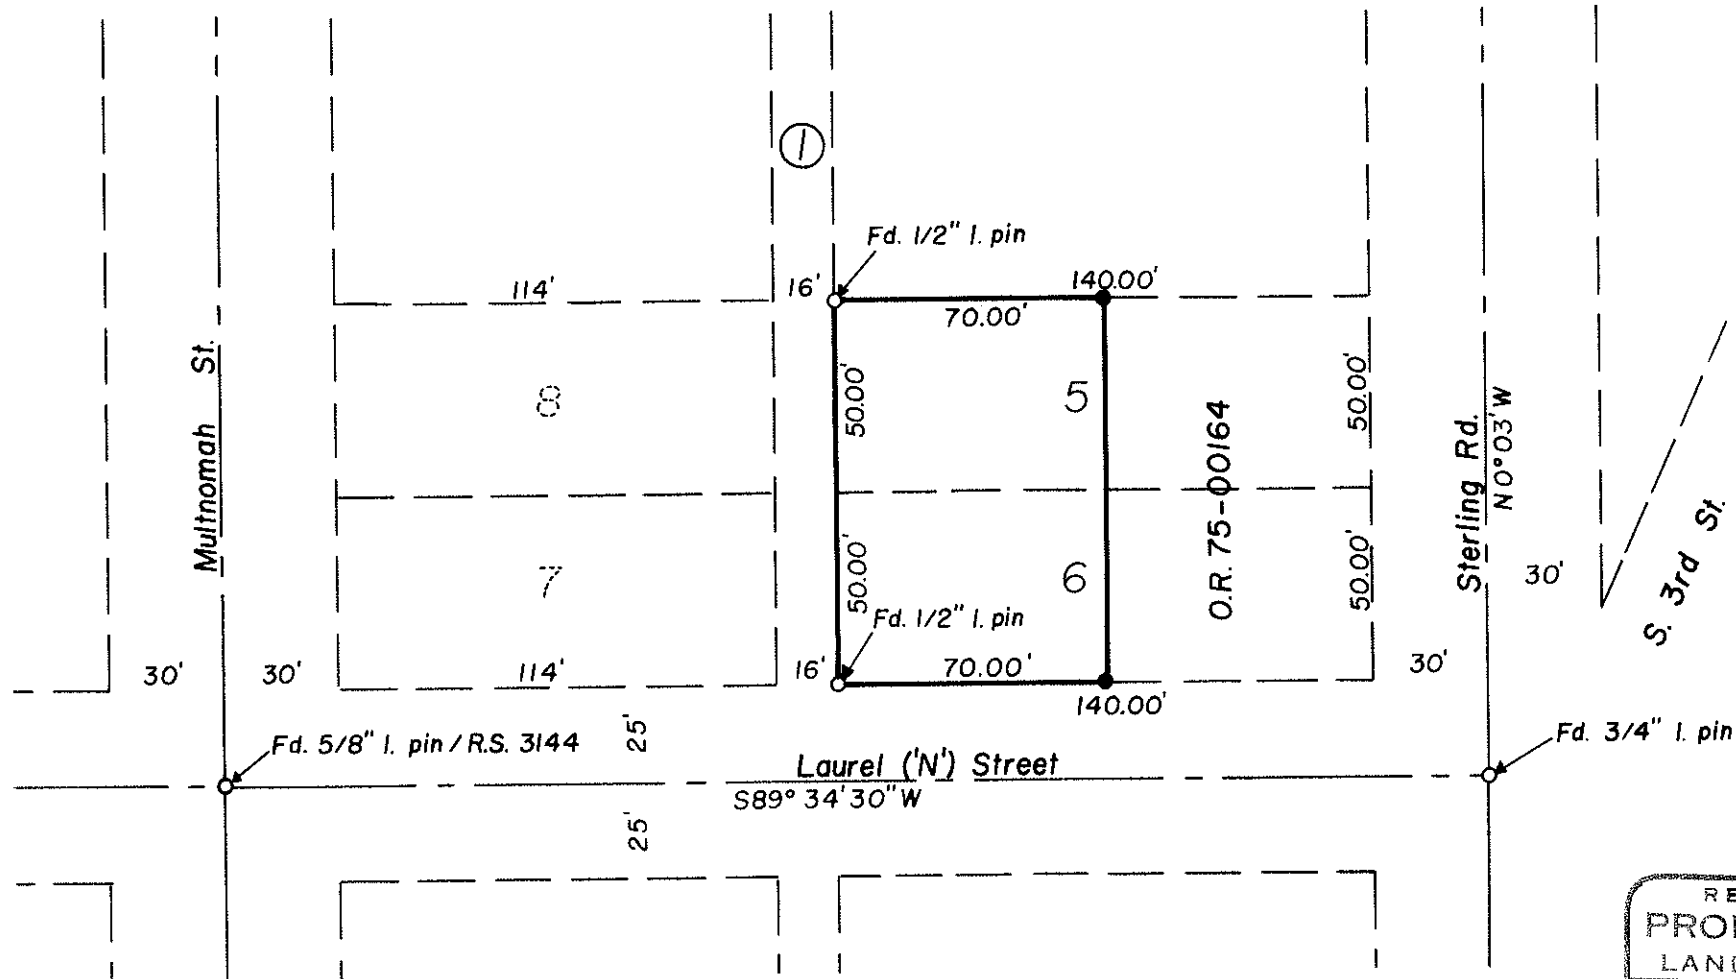

Scale: 1" = 50'
 Basis of Bearings: R.S. 2045
 ● = Set 1/2" x 24" I. pin



REGISTERED
 PROFESSIONAL
 LAND SURVEYOR

C. Lind McBeth

OREGON
 JAN. 12, 1962
 C. LIND MCBETH
 565

Survey for: Mrs. Audrey Reiss
 120 N Street, Jacksonville, Oregon

Located In: Lots 5 & 6, Block I of Lungren Add'n to Jacksonville, Oregon

By: C.L. McBeth L.S., Jacksonville, Oregon

Date: September 21, 1976

6483

Survey Nbr **64830**

SURVEY NARRATIVE TO COMPLY WITH PARAGRAPHS 209.250 O.R.S.

SURVEY FOR: Mrs. Audrey Reiss
120 N. Street
Jacksonville, Oregon 97530

LOCATION: Lots 5 and 6, Block 1, of Lungren Addition to
Jacksonville

PURPOSE: To locate and monument the west line of the real
property described in OR 75-00164 of the Official
Records of Jackson County, Oregon

PROCEDURE: Found monuments at the northwest corner of Lot 5
and the southwest corner of Lot 6 of Block 1 of said
Addition, also street centerline intersection monu-
ments of Sterling Road and Multnomah Street with
Laurel ("N") Street as indicated on the attached
map. Turned record angles per R.S. No. 2045,
measured 70.00 feet easterly from the west line
of said Lots 5 and 6 and set 1/2" x 24" iron pins
to denote the west line of said real property
described in OR 75-00164. Basis of bearings:
R.S. No. 2045.

BY: C. L. McBeth, RLS
P. O. Box 306
Jacksonville, Oregon 97530

September 21, 1976

