

SURVEY PLAT AND NARRATIVE TO COMPLY WITH
PARAGRAPH 209.250, OREGON REVISED STATUTES

Survey for: Jerry Lee and Kay Cagle
c/o General Delivery
Gold Hill, Oregon 97525


Survey by : Charles H. Hurst
304 South Holly
Medford, Oregon 97501

Purpose : To monument the corners of Lot 9, Block 10 of the
Original Townsite of Gold Hill.

Procedure : Based on survey control previously existing as shown.

Bearing : Meridian of Survey No. 4545.

SURVEY SITUATE IN LOT 9, BLOCK 10 OF THE ORIGINAL
TOWNSITE OF GOLD HILL, IN THE NE¼ NW¼ SECTION 22,
T. 36 S., R. 3 W., W.M., JACKSON COUNTY, OREGON.

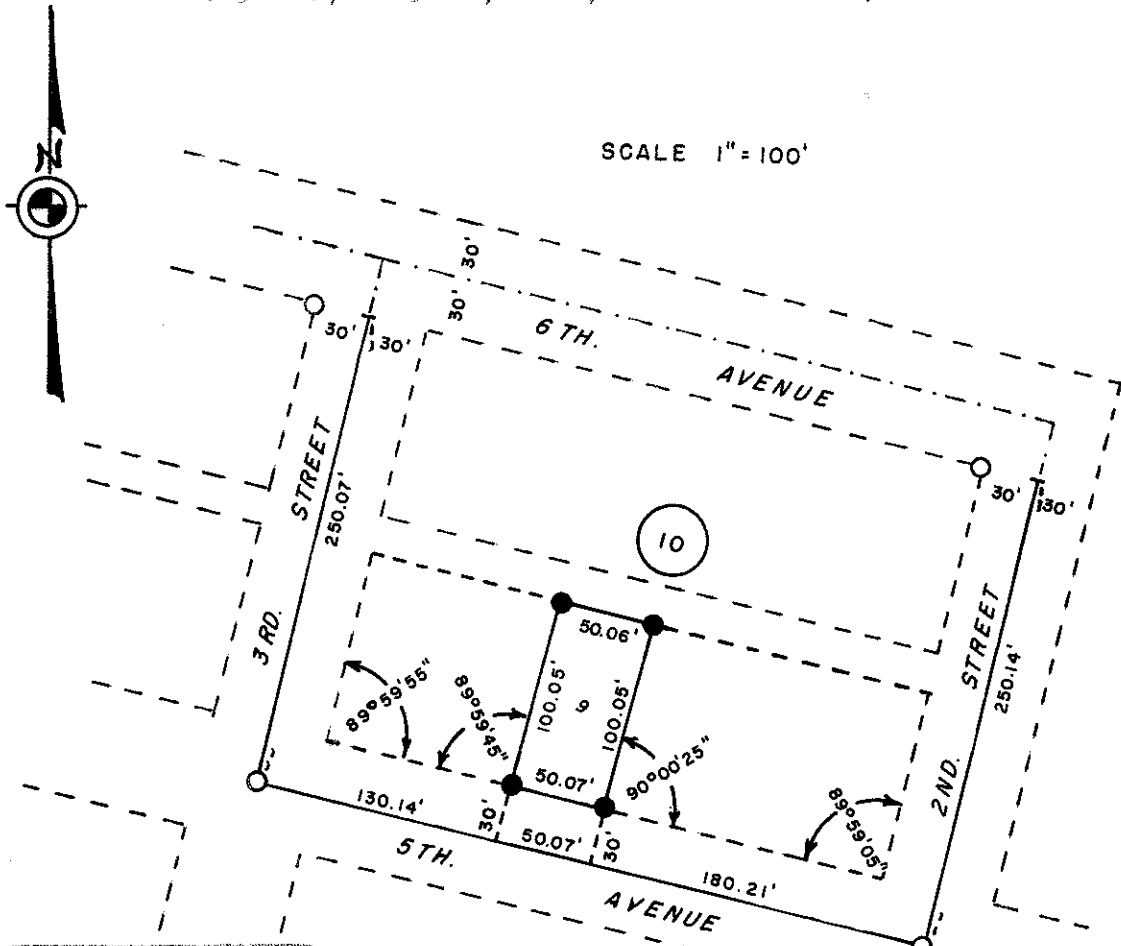

REGISTERED
PROFESSIONAL
LAND SURVEYOR

Charles H. Hurst

OREGON
OCTOBER 30, 1959
CHARLES H. HURST
483

JACKSON COUNTY
RECEIVED
SEP 29 1976
SURVEYOR

LEGEND

- FD. 3/4" IRON PINS (SEE SURVEY NO. 4545)
- SET 5/8" X 24" IRON PINS

SEP 28 1976