

MAP OF SURVEY  
 LOCATED IN  
 DONATION LAND CLAIMS NO. 42 & 44, SEC. 9, TWP. 38S., R. 1 W. W. M.  
 JACKSON COUNTY OREGON  
 FOR


**E. R. CLAFLIN**

EVERETT L. SWAIN, R.L.S. ASHLAND, OREGON  
 SCALE: 1" = 50' AUGUST 4, 1976 Rev. 12/6/76  
 BASIS OF BEARING: RECORDED SURVEY No. 5624

- FOUND MONUMENTS AS SHOWN
- SET 5/8 x 24 INCH IRON PIN TAGGED R.L.S. 759

REGISTERED  
 PROFESSIONAL  
 LAND SURVEYOR  
*Everett L. Swain*  
 OREGON  
 JULY 8, 1966  
 EVERETT L. SWAIN  
 759

JACKSON COUNTY  
 RECEIVED  
 DEC 15 1976  
 SURVEYOR

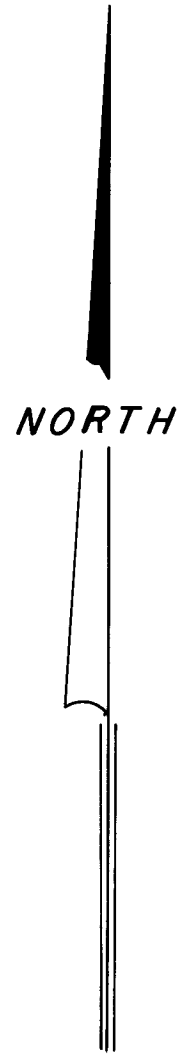

SECTION CORNER  
 Fd. Br. Disk  
 in Mon. Case, mkd  
 T385 RIW

9	10
16	15
1970	

SURVEY NO. 6599

SURVEY NARRATIVE TO COMPLY WITH PARAGRAPH 209.250  
OREGON REVISED STATUTES

SURVEY FOR: Mr. E. R. Claflin  
c/o Mr. Harry A. Skerry, Jr.  
Attorney at Law  
76 North Pioneer Street  
Ashland, Oregon 97520

LOCATION: Situated in Donation Land Claims No. 42 and 44, Section 9, Township 38 South, Range 1 West of the Willamette Base and Meridian, Jackson County, Oregon.

PURPOSE: To survey, monument and prepare a legal description to be used in a "Suit to Quiet Title" of the parcel of land as shown on the accompanying map, per clients request.

PROCEDURE: Recovered street monuments set on Recorded Survey No. 3907 and Survey No. 5624. The monument at the center of Church and Fifth Streets was not recovered. It's position was determined by the utilization of information from the above two (2) surveys. The monuments at the intersection of Fourth and Church Streets, as shown on Recorded Survey No. 5624, does not indicate a monument case situated over these monuments at the time of the survey. There is presently a monument case situated over these found monuments and I have determined that apparently these monuments were disturbed when the monument case was set. Therefore, I have shown a "Detail" drawing to show the relationship of the street intersection to the two (2) monuments found. The remainder of the survey is as shown on the accompanying map.

December 6, 1976

Everett L. Swain  
Professional Land Surveyor  
Ashland, Oregon

