


S.E. Cor. COLLEGE HILL ADDN.
Fd. 3/4" I. Pipe exp. 6"

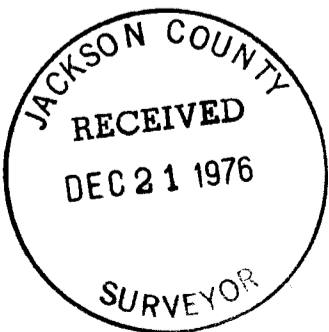

SCALE 1"=60'

Basis of Bearings R.S. 4296

- = Set 5/8"x 24" iron pin
- = Found mon. as noted

REGISTERED
PROFESSIONAL
LAND SURVEYOR

George Burrell

OREGON
JULY 10, 1964
GEORGE P. BURRELL
538

MAP OF SURVEY

Located in lot 35 of S.CHILDERS FAIR-
VIEW EASTERN ADDN. in Section 20
T37 S, RIW in the City of Medford
For: WILLIAM W. BULLOCK **6809**
By: Geo. Burrell, Surveyor, Dec. 1976

S20 CA (2850) T37 RIW

SURVEY NO. **6609**

SURVEY NARRATIVE TO COMPLY WITH O.R.S. 209.250

FOR: William Bullock
1507 Ridge Way
Medford, Oregon

PURPOSE: To monument the Bullock, Johnson and Sprague ownerships according to descriptions furnished. To monument the Westerly 10 feet of the Jennings ownership.

PROCEDURE: The monuments established by Recorded Surveys No. 4296 and 6155 were used as control for the boundaries of lots 35 and 37 of CHILDERS FAIRVIEW EASTERN ADDN., from which the South boundary of lot 35 was established on a proportional basis as shown on the accompanying map. The West 400 feet of lot 35 was established holding record distance per Vol. 312 Page 97 of the Deed Records of Jackson County. The Bullock-Johnson-Sprague ownerships were then monumented according to descriptions furnished by Mr. Bullock.

REGISTERED
PROFESSIONAL
LAND SURVEYOR

George Burrell

OREGON
JULY 10, 1964
GEORGE R. BURRELL
638

