6640

SURVEY FOR U.S. FOREST SERVICE
IN SECTION 24, T.32S. R.2W.W.M., DOUGLAS & JACKSON COUNTY, OREGON
BY: C & G ENGINEERING INC.

DECEMBER 1976

SCALE: 1" = 400'

200 100 50 0 100 300 500 700 900 feet

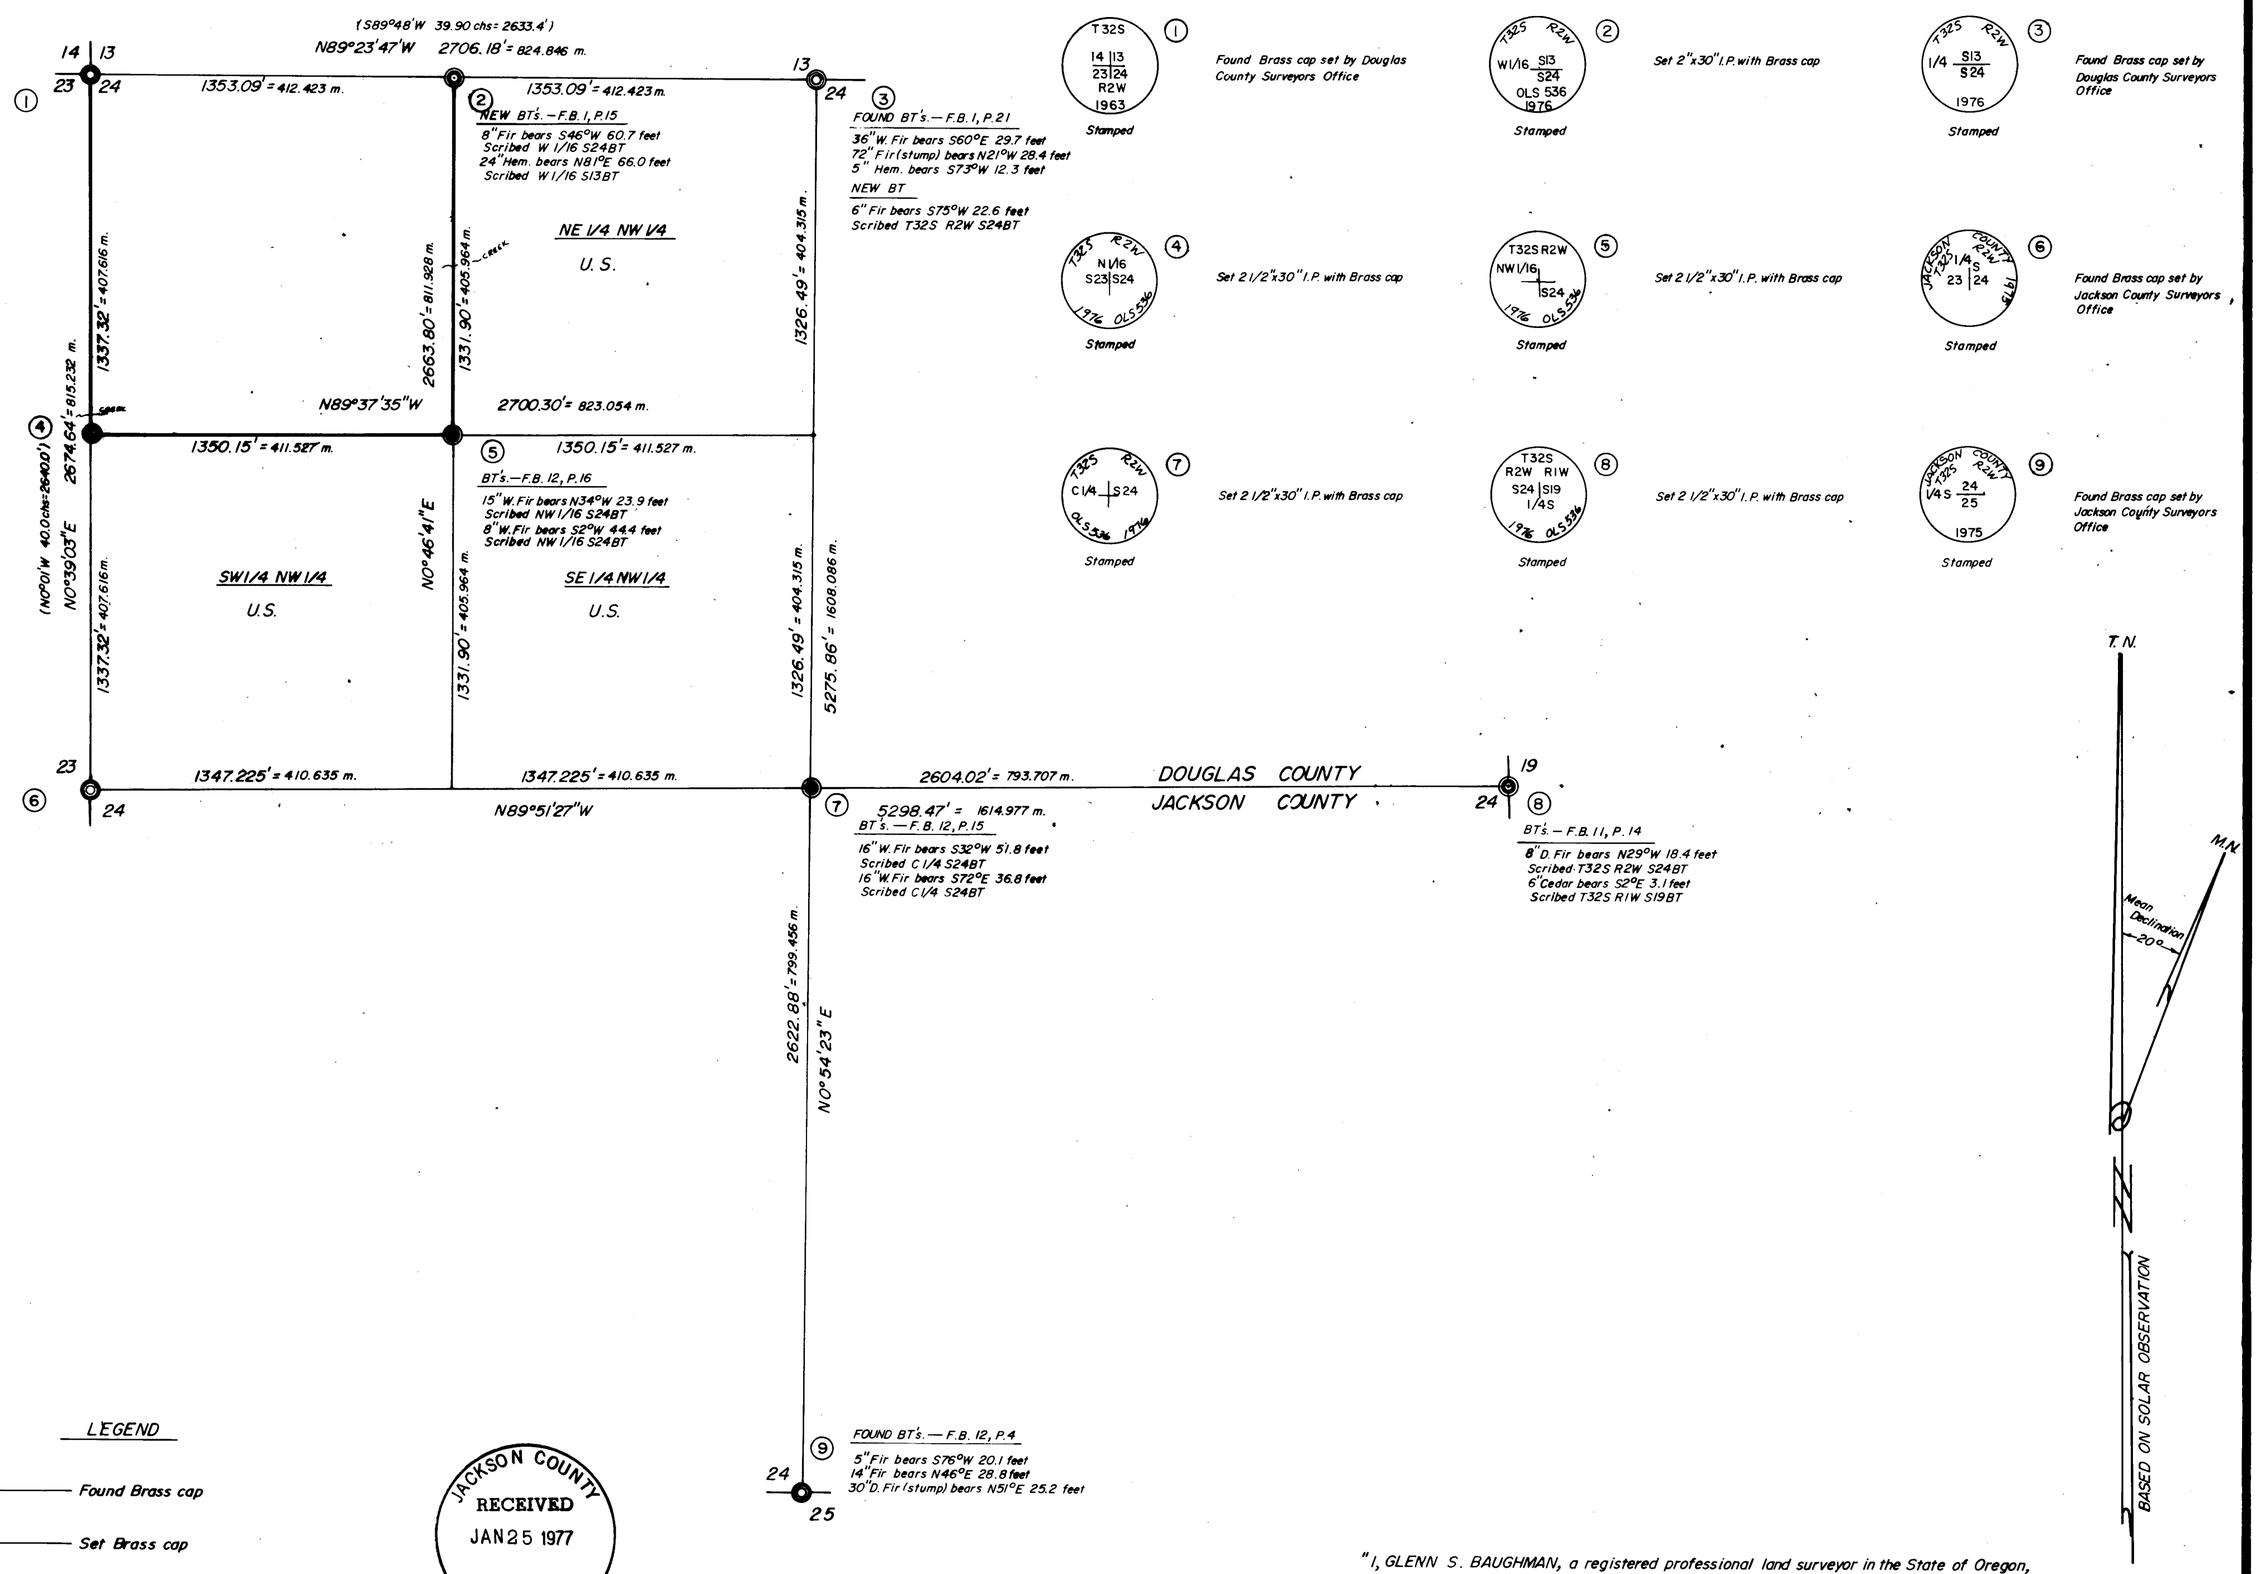

LEGEND

- Found Brass cap
- Set Brass cap
- ( ) Record calls
- True lines posted with steel fence posts and government property signs

JACKSON COUNTY RECEIVED JAN 25 1977 SURVEYOR

"I, GLENN S. BAUGHMAN, a registered professional land surveyor in the State of Oregon, hereby certify that this plat and the notes hereon, or attached, are a correct representation of a survey I performed during July - December 1976, for the U.S. Forest Service, in accordance with the statutes of the State of Oregon and with the Articles of my contract."

Glenn S. Baughman
GLENN S. BAUGHMAN
Registered Professional Land Surveyor
Oregon License 536

Glenn S. Baughman

6640 D

TILLER LAND SURVEY NO.20 CONTRACT NO. 006138-N

6146.0020

6640