

66774

SEE SURVEYS
NO. 2551, 3014

S 61°33'07" E
20.10

W.C.
S.P.R.R.

SURVEY FOR MARQUESS & ASSOCIATES

LOCATED IN S 1/2 SEC. 25, N 1/2 SEC. 36, T. 38 S., R. 1 W., W.M.
JACKSON COUNTY, OREGON

November, 1976



N.E. COR.
Block 4
Hyde Park Sub.
2" Pipe

BOUNDARY LINE AGREEMENT DR 595-171
N 33°57'33" E 295.82
S 33°57'33" W 280.39

S 47°59'16" E 146.78
S 47°59'16" W 165.58
Fence Post
S 56°10'20" E 184.99

N 56°10'20" W 185.19
S 49°05'46" E 207.67
N 49°05'46" W 204.33

S 37°03'12" E 223.69
N 37°03'12" W 212.01

S 14°03'20" E 196.01
N 14°03'20" W 112.57

S 14°03'20" W

S.W. COR.
D.L.C. NO. 72
B. Cap in Conc.

S 89°51'10" E
1119.83

S.E. COR.
D.L.C. NO. 41
B. Cap in Conc.



N 75°56'40" W
220.00

S 14°03'20" W
250.00

S 14°03'20" W
250.00

S 75°56'40" E
220.00

Set Br. Nail in lead plug &
L.S. Tag in Conc.

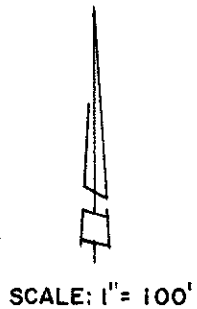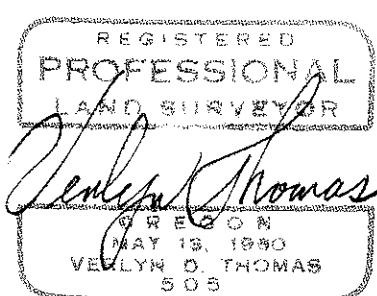

- Monument Found
- 5/8" x 24" Iron Pin Set with L.S. Cap

BASIS OF BEARINGS:
SURVEY NO. 3014

SURVEY BY VERLYN THOMAS, PROFESSIONAL LAND SURVEYOR, MEDFORD, OREGON

66774

25 S
36 38 1W

6677

SURVEY NARRATIVE TO COMPLY WITH O.R.S. 209.250
REVISED BY CHAPTER 555, O.L. 1963

FOR: Marquess & Associates
Goldy Building
Medford, Oregon

PURPOSE: To survey and monument a proposed reservoir site, and
access to said site, as directed by client.

PROCEDURE: Conducted a traverse from the Southwest corner of D.L.C. 72
to the Southeast corner of D.L.C. 41, measuring distances by Electronic
Measuring Device. Made survey measurements to various other monuments
of record, and monumented parcel as shown on the accompanying plat.

