

6691

D.R. 61-502

BDY. MONUMENTED PER SURVEY NO. 2191

WEST

283.42'



5/8" SET IRON PIN

5/8" IRON PIN
0.06' NW 1/4

SURVEY SITUATE IN LOT 15, AMY'S COTTAGE ADDN.
TO THE CITY OF CENTRAL POINT,
(SW 1/4 NW 1/4 SEC. 2 & SE 1/4 NE 1/4 SEC. 3)
T. 37S., R. 2 W., W.M., JACKSON COUNTY, ORE.

FOR
MIKE TRAUTMAN

SCALE: 1" = 50'

SURVEY BY:
CHARLES H. HURST
MEDFORD, OREGON

LEGEND
● SET 5/8" X 24" IRON
REINF. PINS

SOUTH
281.34'
D.R. 255-414


1.581 ACRES

REGISTERED
PROFESSIONAL
LAND SURVEYOR

Charles H. Hurst

OREGON
OCTOBER 30, 1959
CHARLES H. HURST
483

FEB 23 1977

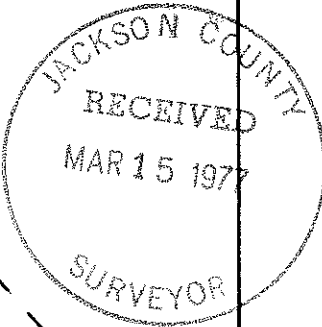

N77°25'45"E
122.07'

124.59'

104.39'

NORTH

123.69'

D.R. 328-483

3/4" IRON PIN
SE COR. LOT 11, BLK. 2
MAZAMA VILLAGE

N79°18'30"E 116.07'
D.R. = N79°20'50"E 116.2'

N55°06'50"E 85.01'
D.R. = N54°55'40"E 85.00'

N89°54'10"E
254.76'

1/4 COR.
"X" ON CONC.
WALKWAY

57.93'

S89°54'10"W 281.01'
D.R. 223.08'

1" SQ IRON BAR

SE COR. LOT 15, AMY'S
COTTAGE ADDN. PER
FILE A, LTR. S., J.C.
ROAD DEPT.

BR. CAP
& MON.

33AD 37 2W

6691

SURVEY NARRATIVE TO COMPLY WITH PARAGRAPH 209.250
OREGON REVISED STATUTES

Survey for: Mike Trautman
829 Hazel Street
Central Point, Oregon

Survey by : Charles H. Hurst
304 South Holly
Medford, Oregon 97501

Bearing : Meridian of Survey No. 2191

Purpose : To separate the tracts shown

Procedure

Transit and tape traverse closing to corners shown on the attached plat.

The southwest corner of D.R. 61-502 was reset from previous control established during the Mazama Village survey, the pin originally set (Survey No. 2191) having been excavated.

February 23, 1977

