6692

SURVEY PLAT & NARRATIVE TO COMPLY WITH
PARAGRAPH 209.250, OREGON REVISED STATUTES

Survey for: Fred H. Goings
31 S. Barneburg Rd.
Medford, Ore. 97501

Survey by: Charles H. Hurst
304 S. Holly
Medford, Ore. 97501

Purpose: To monument the corners shown in accordance with descriptions furnished by the client.

Procedure: Utilization of existing survey control.

SURVEY IN LOT 6, BLOCK 4 OF PIERCE SUBDIVISION, T. 37 S., R. 1 W., W.M.
JACKSON COUNTY, OREGON

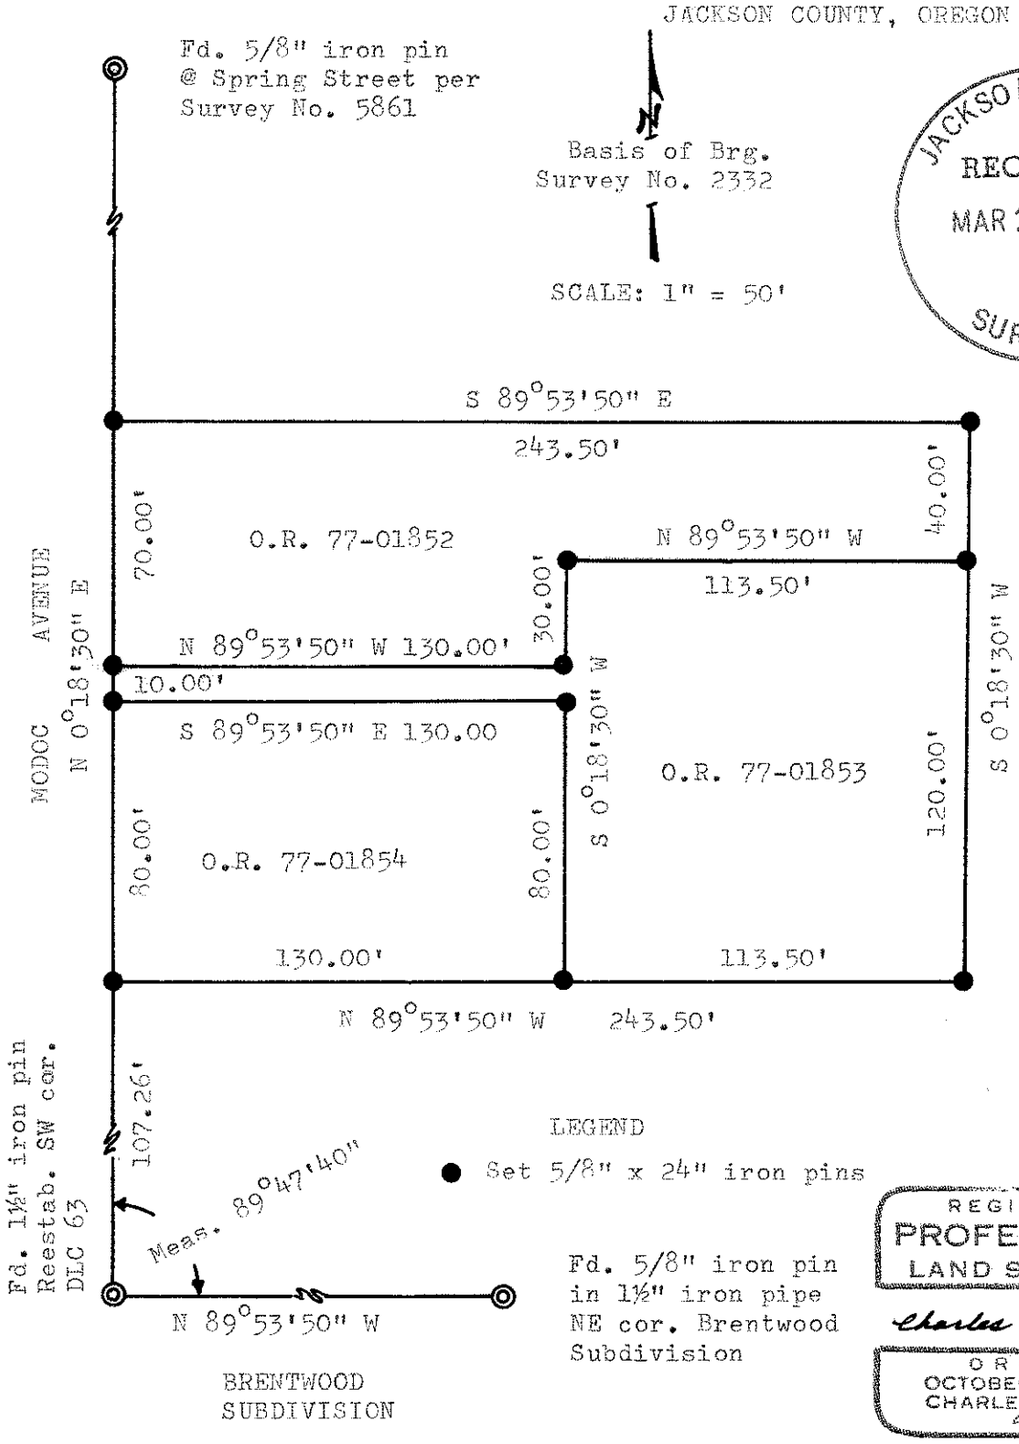

JACKSON COUNTY
RECEIVED
MAR 15 1977
SURVEYOR

REGISTERED
PROFESSIONAL
LAND SURVEYOR
Charles H. Hurst
OREGON
OCTOBER 30, 1959
CHARLES H. HURST
483

FEB 24 1977

6692

S20 T37 R1W 6692