


6694

6694

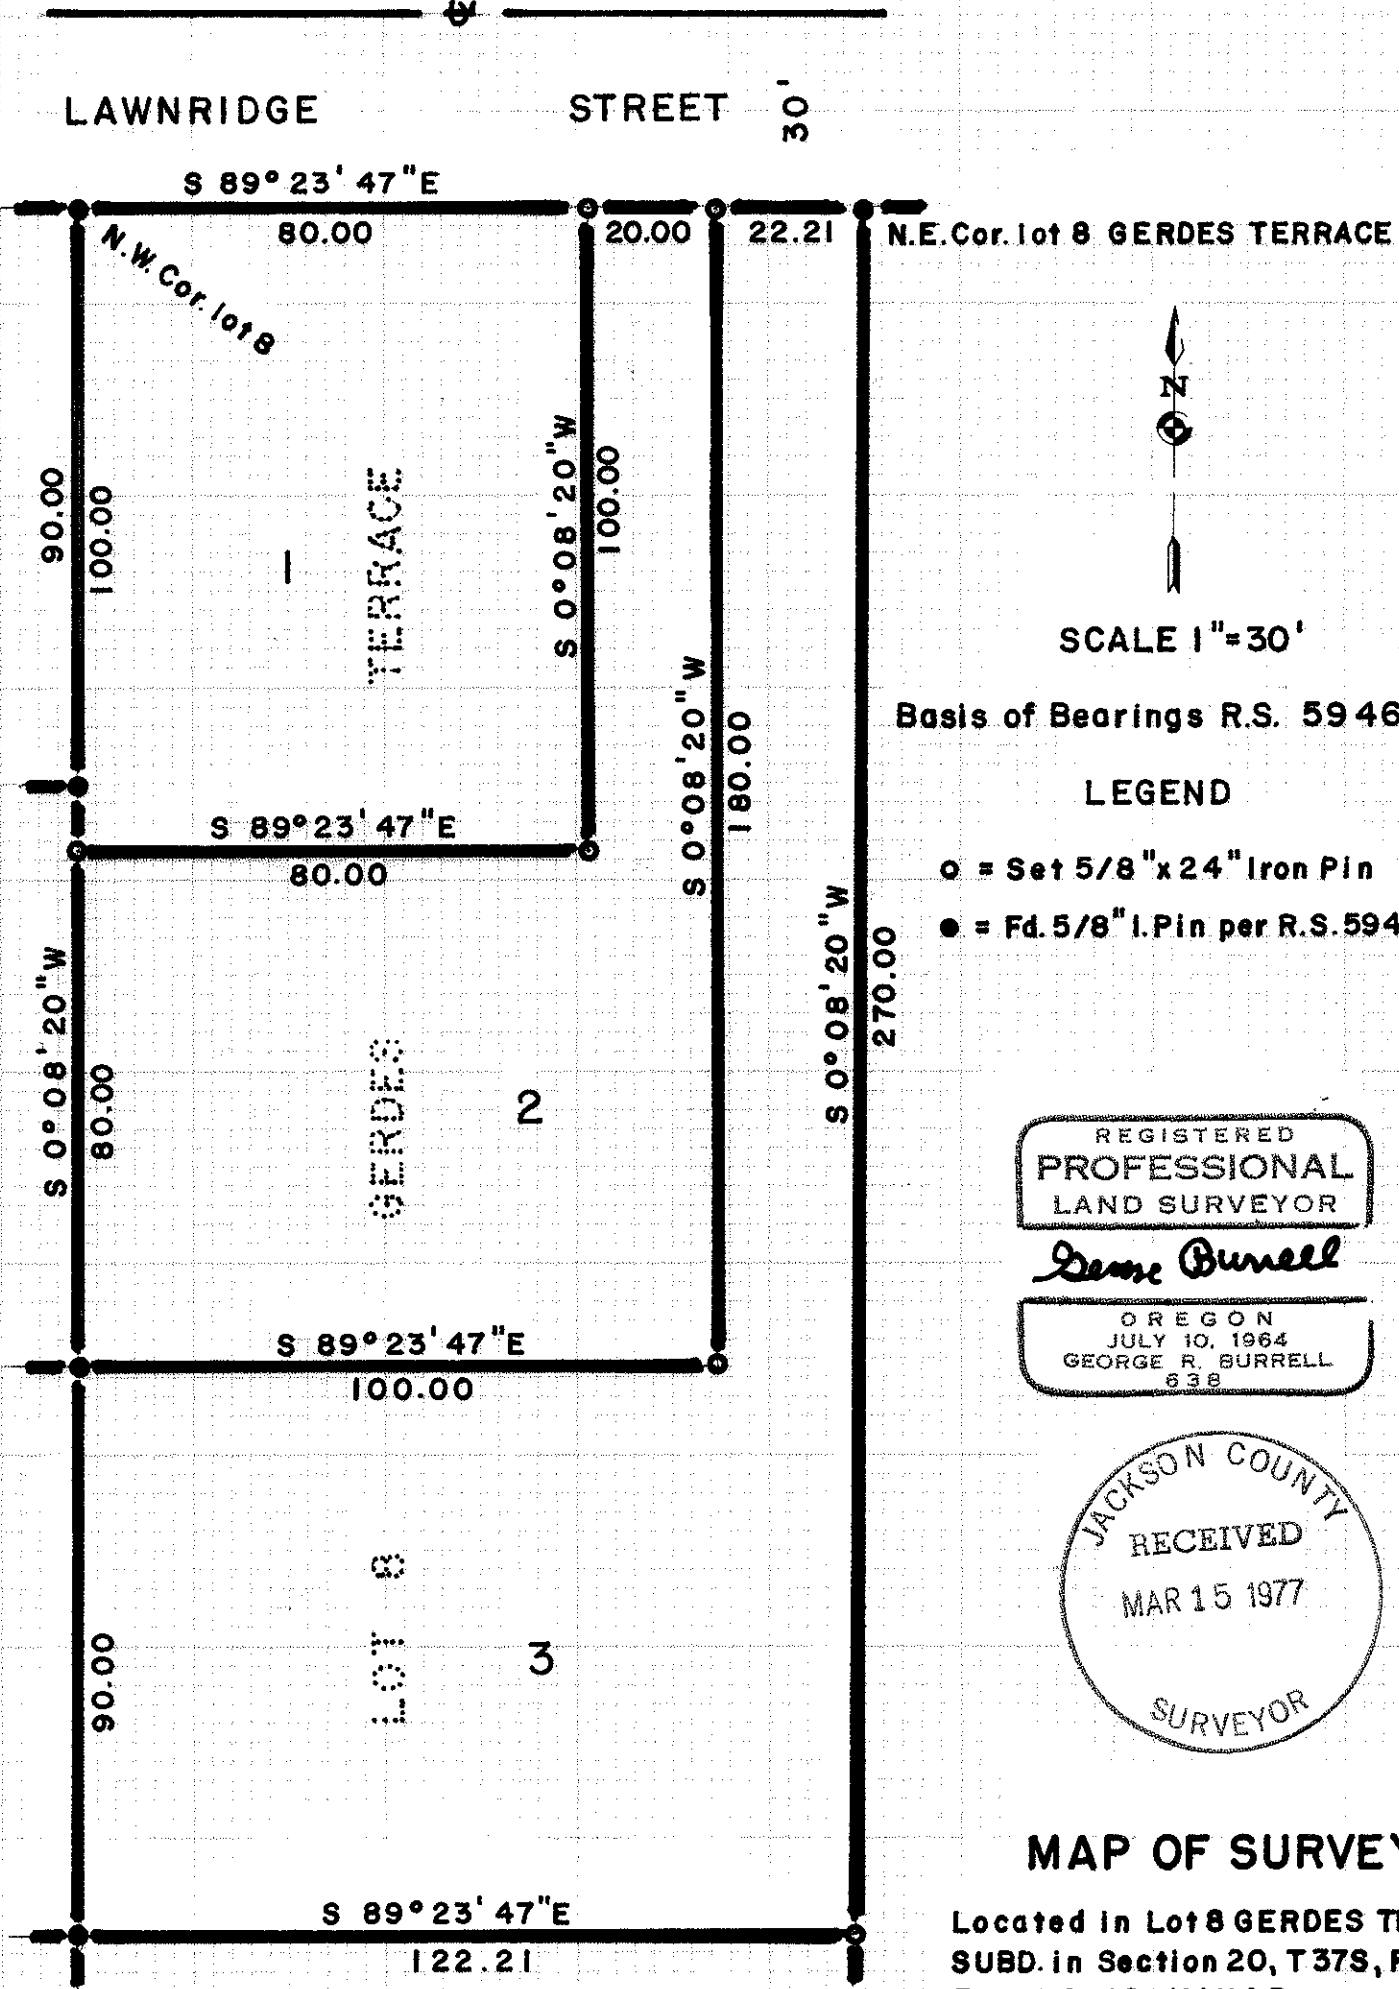

SCALE 1"=30'

Basis of Bearings R.S. 5946


LEGEND

- = Set 5/8" x 24" Iron Pin
- = Fd. 5/8" I. Pin per R.S. 5946

REGISTERED
PROFESSIONAL
 LAND SURVEYOR

Geo. Burrell

OREGON
 JULY 10, 1964
 GEORGE R. BURRELL
 638

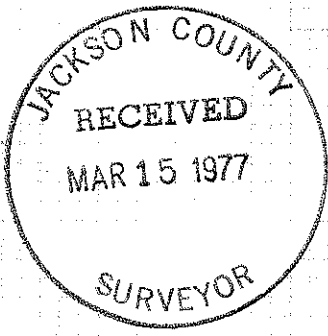

MAP OF SURVEY

Located in Lot 8 GERDES TERRACE
 SUBD. in Section 20, T37S, R1W
 For: LOUIS MAHAR
 By: Geo. Burrell, Surveyor, 2-3-77

6694

SURVEY NARRATIVE TO COMPLY WITH O.R.S. 209.250

FOR: Louis Mahar
314-B Bessie St.
Medford, Oregon

PURPOSE: To monument and describe the three tracts as shown on
the accompanying map.

PROCEDURE: Using the control and procedure of recorded survey no.
5946, said tracts were established according to clients
instructions.

