


SCALE 1"=50'

Basis of Bearings R.S.No.5579

LEGEND

- o = Set 5/8" x 24" Iron Pin
- ⊙ = Fd. 3/8" Copper rod in conc. in mon. case

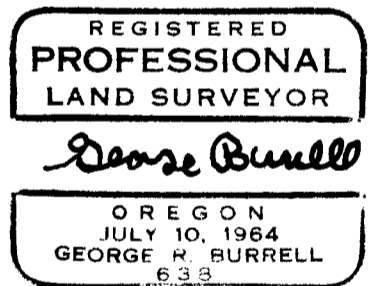

MAP OF SURVEY

Located in Lots 7 and 8 Block 49
in the ORIG. TOWN OF CENTRAL
POINT in S.W. 1/4 Sec. 2 T37SR2W
For: CENTRAL POINT STATE BANK
By: Geo. Burrell, Surveyor 3/25/77

SURVEY NO. **6752**

SURVEY NARRATIVE TO COMPLY WITH O.R.S. 209.250

FOR: Central Point State Bank
Fifth and Pine
Central Point, Oregon

PURPOSE: To monument lots 7 and 8 Block 49 of Original Town of
Central Point.

PROCEDURE: Traversed the exterior of Block 49 through the centerline
monuments as found, from which the proportional lot
distances were developed and monuments established as
shown on the accompanying map.

REGISTERED
PROFESSIONAL
LAND SURVEYOR

George R. Burrell

OREGON
GEORGE R. BURRELL
638

