

6781

6781

FD. 14" D. FIR N 32° E 27.7' BLAZE HEALED
FD. 15" B. OAK S 20° E 21.5' DEAD & DOWN
FD. 10" B. OAK N 53° W 31.0' SCRIBING VISIBLE

SCRIBED:
12" B. OAK S 73° 55' W 72.9' S9 BT RE3024
18" S. PINE S 72° 25' E 41.8' S10 BT RE 3024



4 3
9 10

1273.3'

25466'

SET 10" X 6" X 6" STONE FOR N1/16 COR.
SCRIBED:
22" W. OAK N 33° 20' E 32.5' N1/16 S10 BT RE3024
25" W. OAK WEST 57.2' N1/16 S9 BT RE 3024

S 01° 53' W

1273.3'

SECTION 10, T.37S, R.4W, W.M.

SET 12" X 6" X 6" STONE FOR 1/4 COR.
FD. 34" B. OAK N 14° E 75.3' BLAZE HEALED
FD. 22" B. OAK S 73° W 31.7' BLAZE HEALED

1311.9'

SET 1/2" I. ROD 24" LONG - 18" IN GROUND FOR 1/16 COR.
SCRIBED:
8" S. PINE S 74° 40' E 38.7' S1/16 S10 BT RE3024
18" CEDAR S 32° 55' W 30.5' S1/16 S9 BT RE3024


2623.8'

S 01° 01' W

1311.9'

FD. 12" B. OAK N 41° 10' W 58.1' SCRIBED T37S R4W S9 BT, W/79 YRS. OF OVERGROWTH
FD. B. OAK SPROUT S 52° 45' E 44.0'
FD. 10" B. OAK, N 48° 35' E 54.8' SCRIBING VISIBLE ON NEGATIVE
SET 12" X 14" X 18" STONE WITH 4 NOTCHES ON SW EDGE FOR COR.
SCRIBED:
12" S. PINE S 74° 40' E 38.7' S15 BT RE3024
12" CEDAR S 32° 55' W 30.5' S16 BT RE3024

9 10
16 15

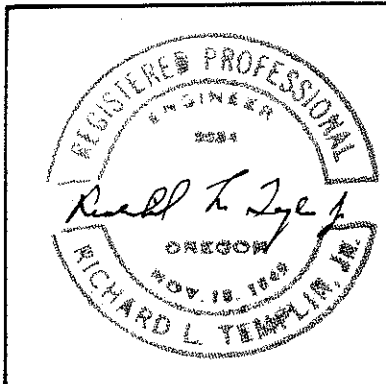

RICHARD L. TEMPLIN
CONSULTING ENGINEER

PLAT OF SURVEY
WEST BOUNDARY OF SECTION 10
LOCATED IN
T. 37S, R. 4 W, W. M.
JACKSON COUNTY, OREGON

SURVEYED FOR: SUNNY VALLEY LBR. CO.
SCALE: 1" = 500'

GRANTS PASS, OREGON
MAY 15, 1956

6781

- A 12" B. Oak bears N 41°10' W, 58.1 ft. distant, scribed- T 37S, R 4 W
S 9 BT, with 79 yrs. of overgrowth.
- A B. Oak sprout S 52°45' E, 44.0 ft. distant.
- A 10" B. Oak bears N 48°35' E, 54.8 ft. distant, scribing visible on negative.

I scribe the following new BTs:


- A 12" S. Pine S 74°40' E, 38.7 ft. distant, mkd. S15 BT RE 3024.
- A 12" Cedar S 32°55' W, 30.5 ft. distant, mkd. S16 BT RE 3024.

This survey was executed with a Gurley Solar Instrument, 200 ft. steel tape with distances measured on the slope and vertical angles measured with a clinometer in good adjustment.

The purpose of the survey was to establish cutting lines for logging on the SW¹/₄ nw¹/₄ and the NW¹/₄SW¹/₄. These lines were all blazed and spray painted a bright red. Merchantable trees outside the property were blazed on the side facing the property with three vertical blazes which were also painted red.

All new bearing tree faces were also painted a bright red.

Bearings are based on observations with the solar instrument. Weather was clear and bright.

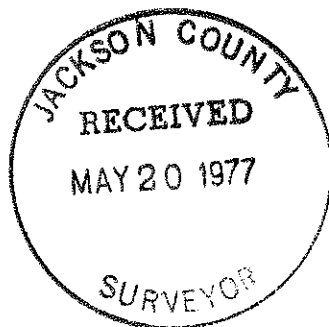

RICHARD L. TEMPLIN
CONSULTING ENGINEER

321 NORTHWEST A STREET
GRANTS PASS, OREGON 97526

REGISTERED ENGINEER OREGON
REGISTERED LAND SURVEYOR CALIF.

May 15, 1956

TEL. (503) 476-7114

SURVEY NARRATIVE

Location: Section 10, T. 37S., R. 4W., W.M., Jackson County, Oregon.

Surveyed For: Sunny Valley Lumber Co., Grants Pass, Oregon.

Purpose: To survey and monument the West Boundary line of Section 10.

Commencing at the corner common to sections 3, 4, 9, and 10 from which bears the following original witness trees:

- A 14" D. Fir bears N 32° E, 27.7 ft. distant, blaze healed.
- A 15" B. Oak bears S 20° E, 21.5 ft. distant, dead and down.
- A 10" B. Oak bears N 53° W, 31.0 ft. distant, scribing visible.

I scribe the following new BTs:

- A 12" B. Oak bears S 73°55' W, 72.9 ft. distant, mkd. S 9 BT RE3024.
- A 18" S. Pine bears S 72°25' E, 41.8 ft. distant, mkd. S 10 BT RE 3024.

thence, S 01°53' W, on a true line between sections 9 and 10, 1273.3 ft. to a point for the N 1/16 corner of sections 9 and 10 set at proportional distance. Set a 10 x 6 x 6 inch stone for corner from which:

- A 22" W. Oak bears N 33°20' E, 32.5 ft. distant, mkd. N 1/16 S10 BT RE 3024.
- A 25" W. Oak bears West 57.2 ft. distant, mkd. N 1/16 S 9 BT RE 3024.

thence, S 01°53' W, on a true line between sections 9 and 10, 1273.3 ft. to a point for the 1/4 corner of sections 9 and 10 which I monument with a stone 12 x 6 x 6 inches for the corner from which the following original witness trees bear:

- A 34" B. Oak bears N 14° E, 75.3 ft. distant, blaze healed.
- A 22" B. Oak bears S 73° W, 31.7 ft. distant.

thence, S 01°01' W, on true line between sections 9 and 10, 1311.9 ft. to a point for the S 1/16 corner of sections 9 and 10 set at proportional distance. Set a 1/2" iron rod 24" long and 18" in the ground for the corner from which:

- A 8" S. Pine bears S 74°40' E, 38.7 ft. distant, mkd. S1/16 S10 BT RE3024.
- A 18" Cedar bears S 32°55' W, 30.5 ft. distant, mkd. S1/16 S9 BT RE3024.

thence, S 01°01' W, on true line between sections 9 and 10, 1311.9 ft. to a point for the section corner common to Sections 9, 10, 15 and 16 which I monument with a stone 12 x 14 x 18 inches with four notches on the SW edge set in a mound of stone from which the following original witness trees bear:

