

6792

2669



REGISTERED  
 PROFESSIONAL  
 LAND SURVEYOR


*Edward A. McGinty*

OREGON  
 JULY 10, 1959  
 EDWARD A. MCGINTY  
 801

DEPENDENT SURVEY  
 IN SW. 1/4 SEC. 21 T.35 S., R.1 W., W.M.  
 FOR: JAMES GRIFFITH  
 66-22-B

BY EDWARD A. MCGINTY  
 MEDFORD, OREGON  
 APRIL 1977

SCALE 1" = 100'  
 ° = 5/8" I.PIN FD.  
 • = 5/8" x 24" I.PIN

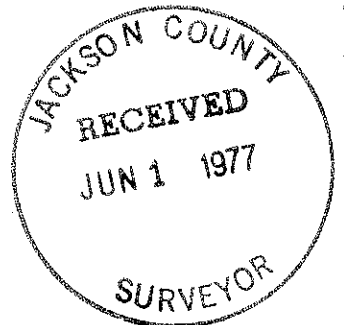

6792

5792

SURVEY NO. 679

SURVEY NARRATIVE TO COMPLY WITH O.R.S. 209-250

Survey for: Mr. James Griffith 66-22-B  
2338 Taylor Rd.  
Central Point, Ore.

Survey by: Edward A. McGinty, R.S.  
Medford, Oregon  
April, 1977

Basis of Bearing: Survey No. 3887

Location of Survey: The SW. 1/4 of Sec. 21, T35S, R1W., WM.  
Jackson County, Oregon

Precedence of Survey:

This is a dependent survey from previous surveys of record: No.s 3887 and 3049.

The easterly line was determined from 5/8 in. iron pins recovered surveys No. 3049 and 3887.

The westerly line was a projection of the southerly line established on survey No. 3887 and the northerly and southerly line of tract was recorded and computed.

The description was prepared from survey for a possible segregation.

Monuments set being 5/8 in. x 24 in. iron pins, set approx. flush with the surface.

