DEPARTMENT OF PUBLIC WORKS
LOCATED LINE

SLAGLE CREEK ROAD

KUBLI ROAD - 1.5 mi. EAST

JACKSON COUNTY

NOVEMBER 1975 **9797**

SCALE : 1" = 100'

● Indicates set 5/8" x 30" iron pin & guard post. All pins are at right angles to centerline and set flush, unless otherwise noted.

◔ Indicates existing 5/8" x 30" iron pin. Distance to pin is measured at right angle to centerline.

Basis of bearing: 1969 Slagle Creek Road Notes.

Purpose of survey. To define the boundaries of the road right of way owned by Jackson County.

Procedure: Retraced line according to 1969 Jackson County Road Records. All coordinates based on 1975 survey.

Right-of-Way: Acquired by deed and petition.
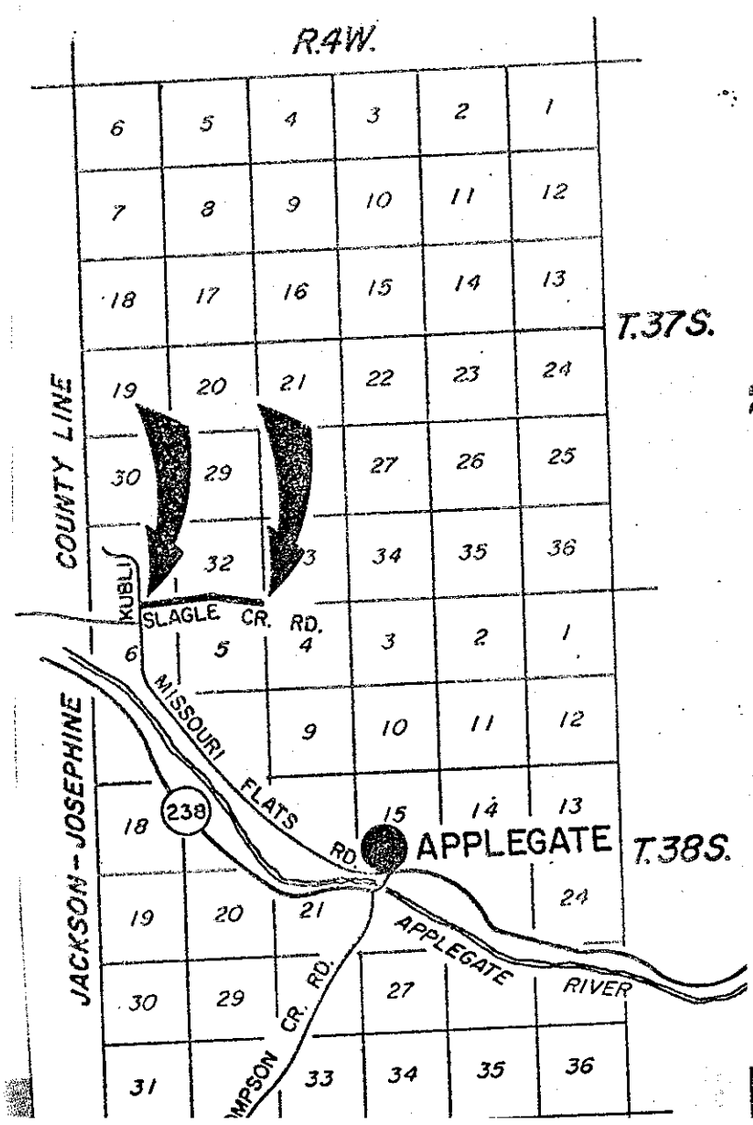
Survey Completed: November, 1975.