

DEPARTMENT OF PUBLIC WORKS
LOCATED LINE

CHINA GULCH ROAD
HWY. 238-TWIN OAKS DRIVE

JACKSON COUNTY

MARCH 1976

6799

SCALE: 1"=100'

● Indicates set 5/8"x 30" iron pin & guard post. All pins are at right angles to centerline and set flush, unless otherwise noted.

○ Indicates existing 5/8" iron pin. Distance to pin is measured at right angle to centerline.

Basis of bearing: 1970 China Gulch Road Notes.


Purpose of survey. To define the boundaries of the road right of way owned by Jackson County.

Procedure: Retraced line according to 1968-70 Jackson County Road Records.

All coordinates based on 1976 survey.

Right-of-Way: Acquired by Deed and Petition.

Survey completed: March, 1976.

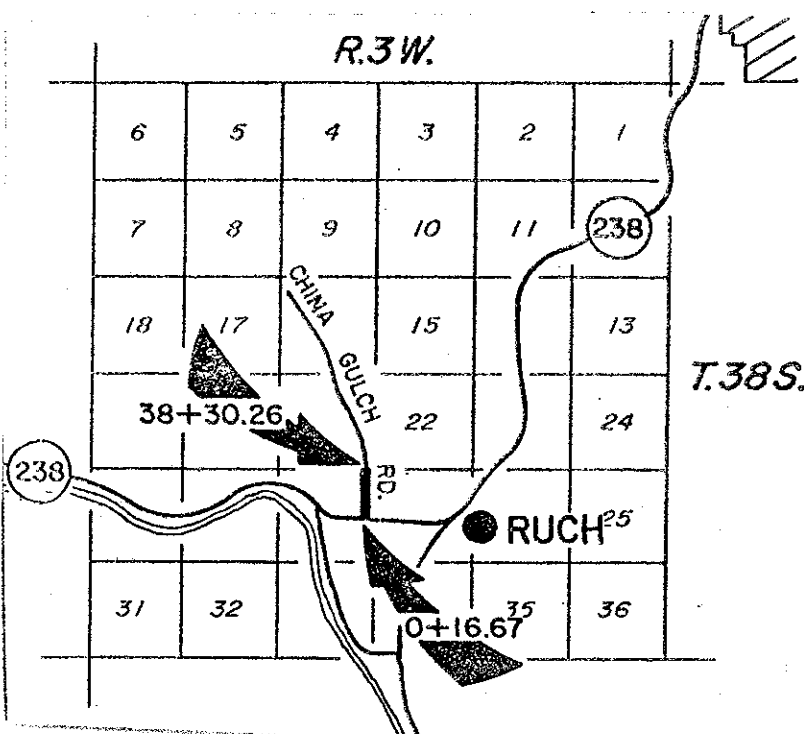

T.38S.