

REC. = DISTANCE & BEARING OF RECORD
 ● 3/4" BLK STEEL PIPE
 LOCATION OF 3/4" PIPE SET BY THIS SURVEY APPROVED BY BOTH PRINCIPAL LANDHOLDERS WHOSE LAND IS HEREBY DIVIDED NAMELY CLIFF W. BAGLEY & BOB BELLAMY
 I HEREBY ATTEST TO THE ABOVE:

/S/	5/26/77
CLIFF W. BAGLEY	DATED
/S/	5/26/77
BOB BELLAMY	DATED



MAP OF SURVEY
 LOCATED IN
 SEC 21, 28, 29 T34S RIW W.M.
 JACKSON COUNTY
 OREGON
 FOR
CLIFF W. BAGLEY
 LARRY G. SWEEM REG. CIVIL ENGR.
 SHADY COVE ORE
 SCALE: 1" = 500' 23 MAY 1977
 REFERENCE: SURVEY for ROBERT E. COREY
 by J.A. HOFFBUHR dated NOV 14, 1974
 SURVEY NO 6205

SURVEY NO. 6820 - A

SURVEY NARRATIVE TO COMPLY WITH O.R.S. 209.250

SURVEY FOR: Cliff W. Bagley
Rogue River Drive
Eagle Point, Oregon


LOCATION: A PORTION OF SECTIONS 21, 28, & 29,
TOWNSHIP 34 SOUTH, RANGE 1 WEST, WILLAMETTE
MERIDIAN, JACKSON COUNTY, OREGON.

PURPOSE: TO ESTABLISH THE SOUTH BOUNDARY OF THE PARCEL
SHOWN ON ATTACHED MAP.

PROCEDURE: A TRAVERSE WAS RUN FROM THE FOUND 5/8" IRON PIN ON
ROGUE RIVER DRIVE TO A POINT 500 FT. SOUTH OF THE FOUND
SECTION CORNER COMMON TO SECTIONS 20, 21, 28, & 29,
THENCE ON TO A MEANDER POINT ON THE WEST BANK OF THE
ROGUE RIVER. THE MEANDER POINT WAS RE-ESTABLISHED FROM
ADJACENT MEANDER STAKES FOUND FROM PREVIOUS SURVEY
NO. 6205. THE LOCATION OF MONUMENT SET BY THE SURVEY WAS
JOINTLY APPROVED BY BOTH PRINCIPAL LANDHOLDERS WHOSE
LAND WAS THEREBY DIVIDED.

MONUMENTS SET ARE SHOWN ON ATTACHED MAP & ARE 3/4" PIPE 3' LONG.

DATE: MAY 23, 1977

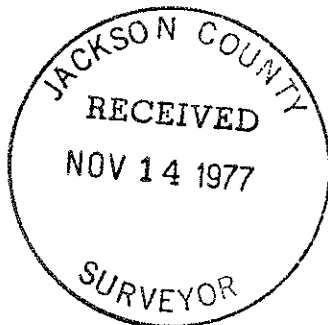

SURVEY NO. **6820**

SURVEY NARRATIVE TO COMPLY WITH O.R.S. 209.250

SURVEY FOR: Bob Bellamy & Cliff W. Bagley
Rogue River Drive
Eagle Point, Oregon

LOCATION: A PORTION OF SECTIONS 21, 28, & 29,
TOWNSHIP 34 SOUTH, RANGE 1 WEST, WILLAMETTE
MERIDIAN, JACKSON COUNTY, OREGON.

PURPOSE: TO DIVIDE THE PARCEL OF LAND AS SHOWN ON
ATTACHED MAPS.

PROCEDURE: THE TWO POINTS THAT DIVIDE THE PARCEL
1. 500' SOUTH OF FOUND SECTION CORNER
20, 21, 28, 29
2. A POINT PREVIOUSLY USED AS A MEANDER POINT
ON THE WEST BANK OF THE ROGUE RIVER.
THIS POINT WAS ESTABLISHED FROM STAKES FOUND
ON ADJACENT MEANDER POINTS UP & DOWN STREAM.

MONUMENTS SET ARE SHOWN ON ATTACHED MAPS & ARE
3/4" IRON PIPE 3' LONG.

DATE: MAY 23, 1977

