
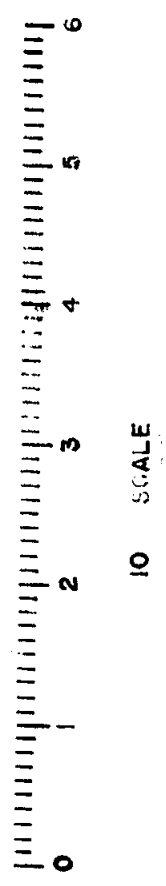


8 9
17 16

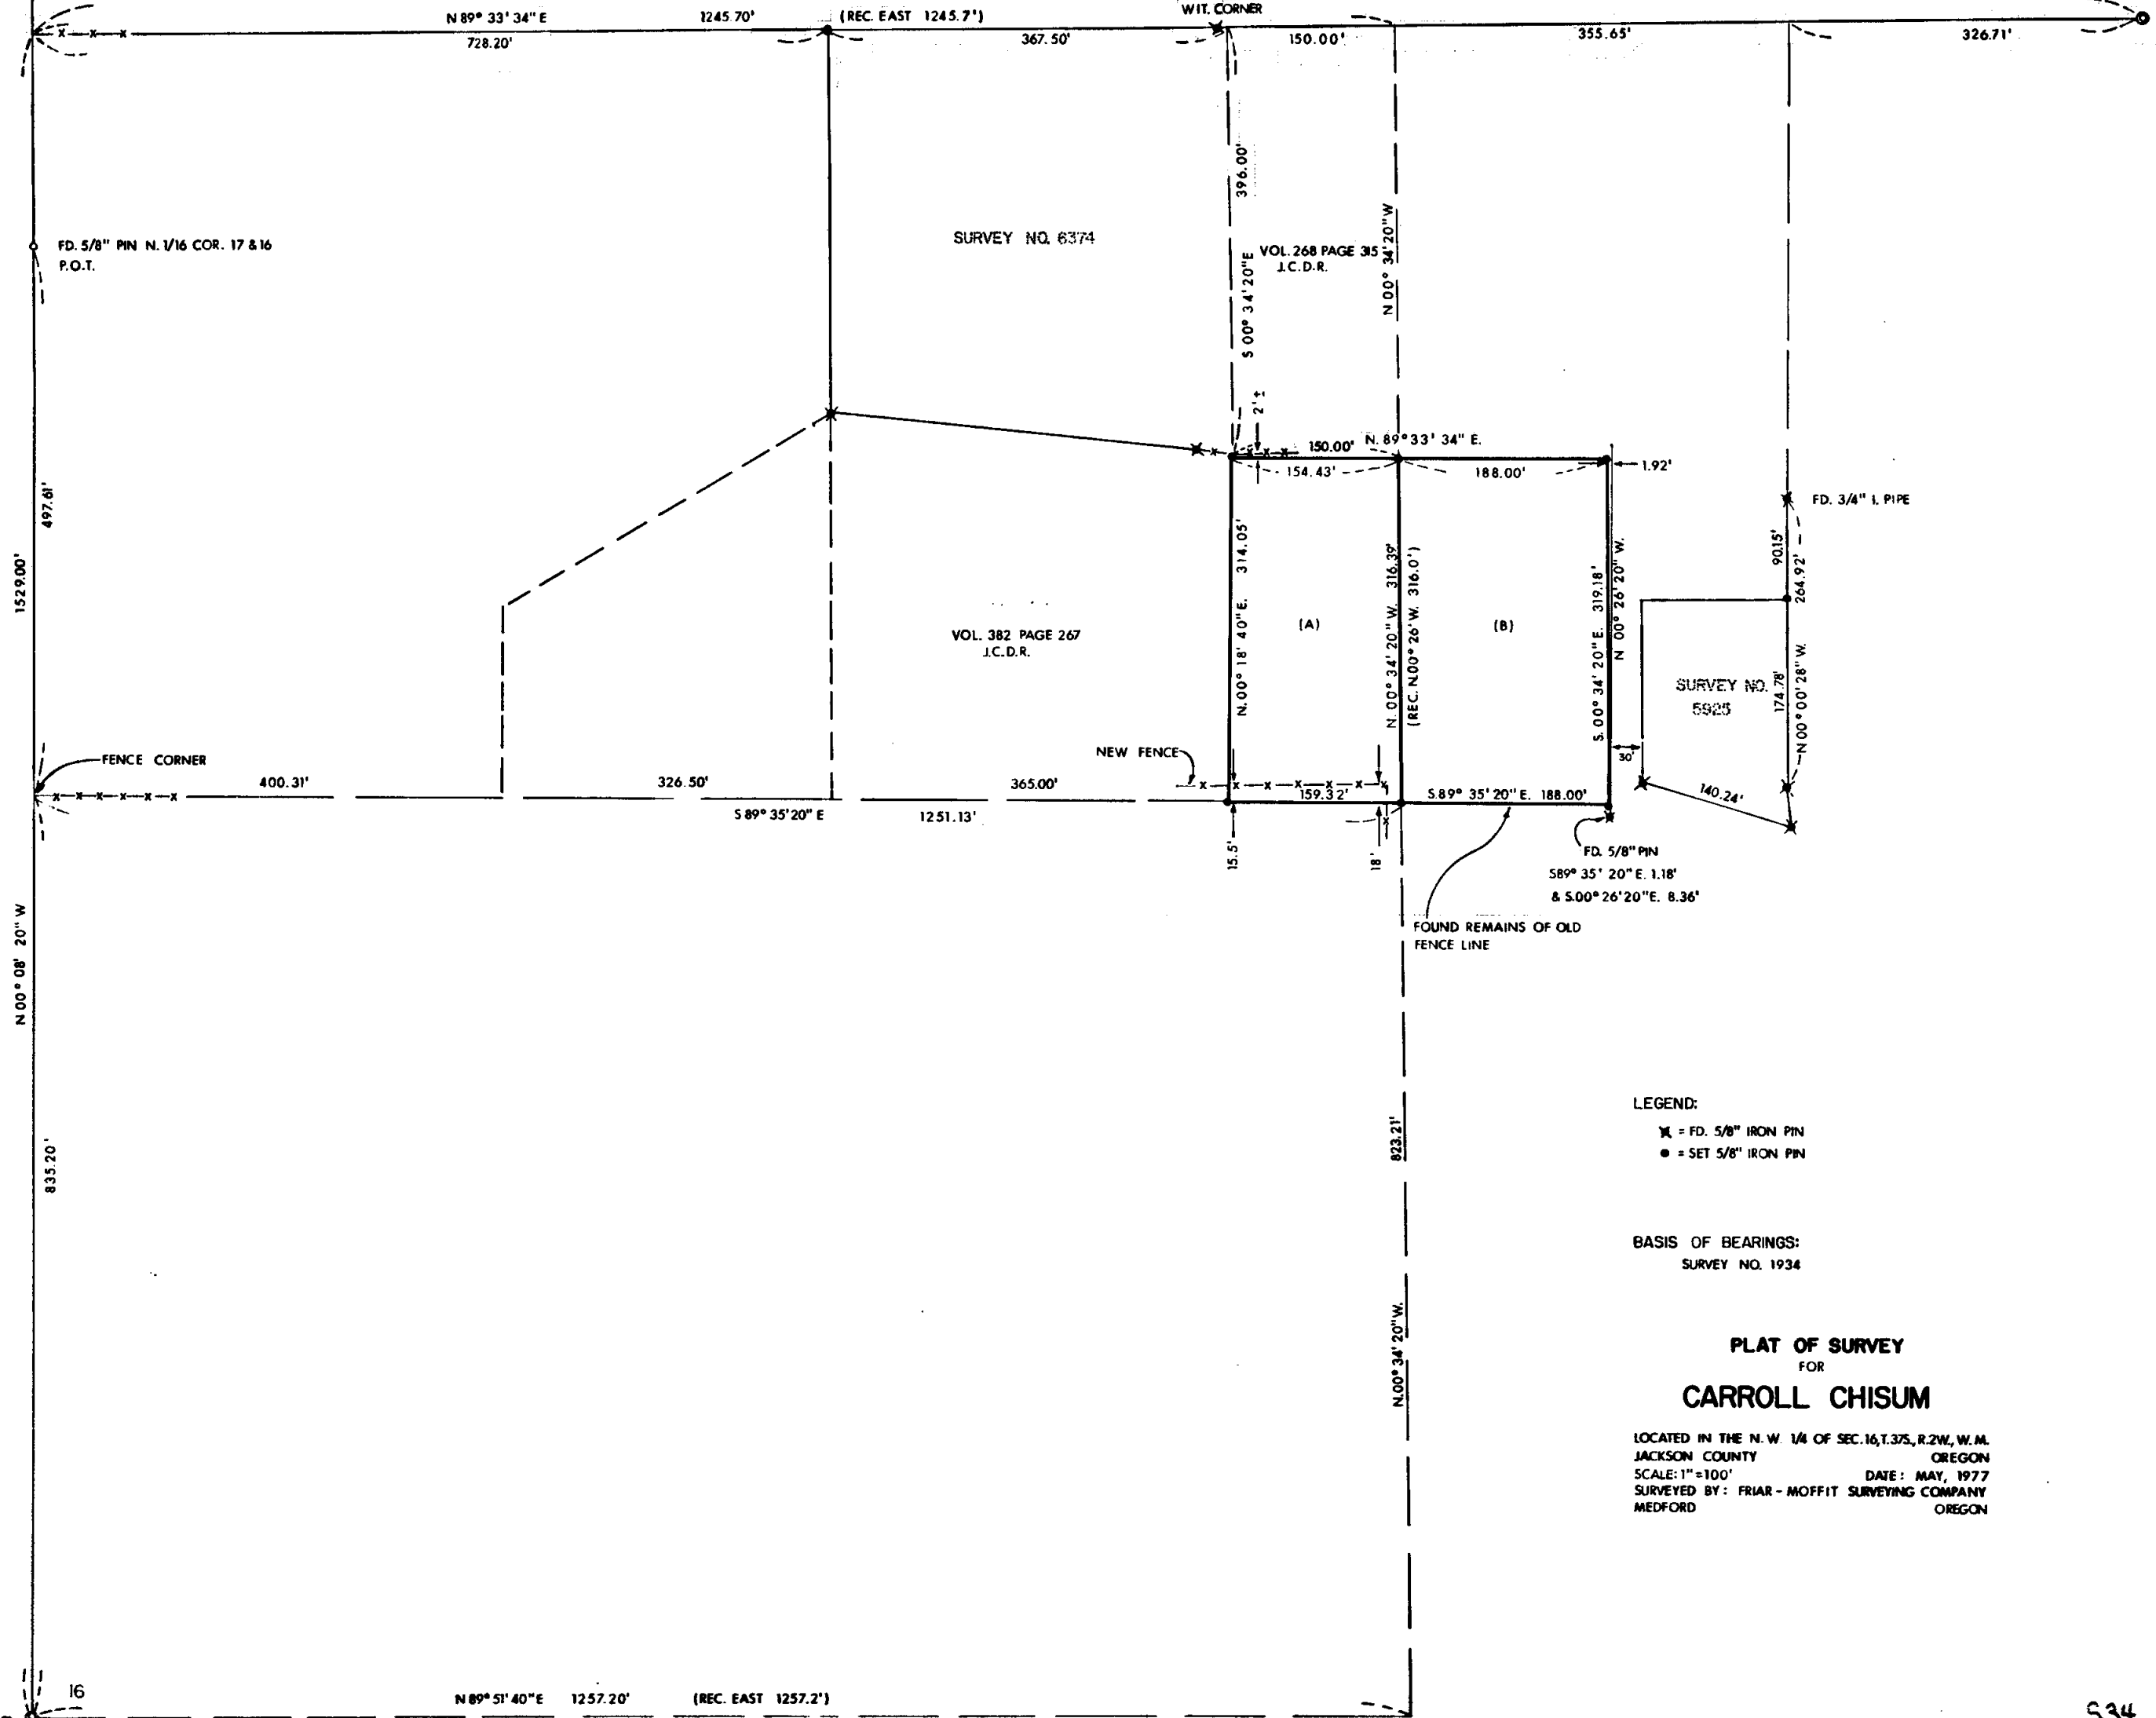

JACKSON COUNTY
 RECEIVED
 JUL 22 1977
 SURVEYOR

REGISTERED
 PROFESSIONAL
 LAND SURVEYOR

Carroll Chisum
 OREGON
 JULY 18, 1971
 LARRY J. FRIAR
 521