



6862

SPRING ST.

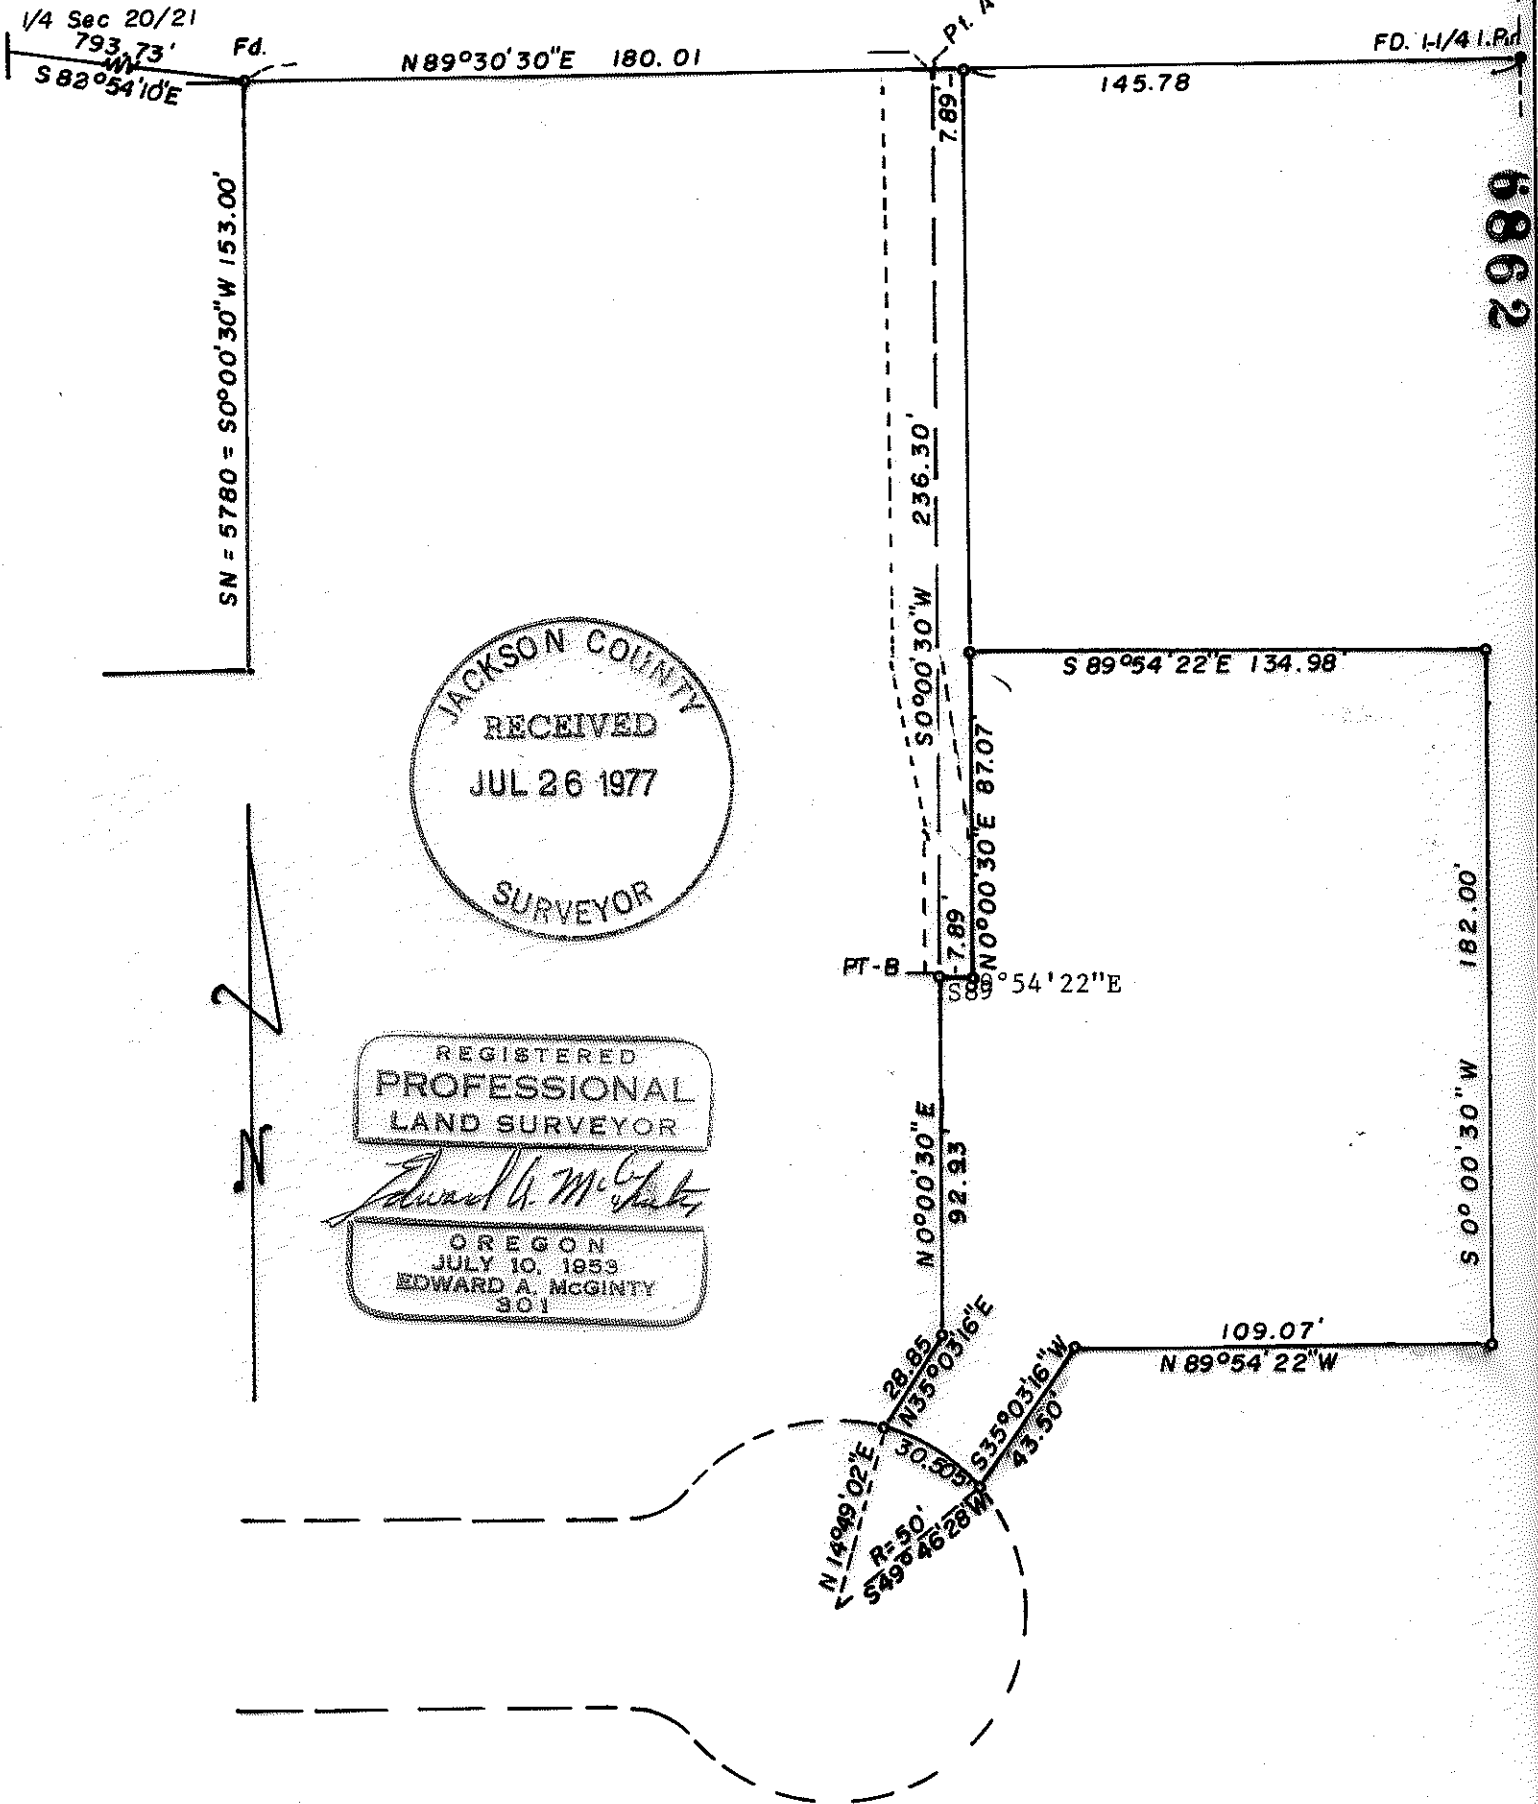

6862

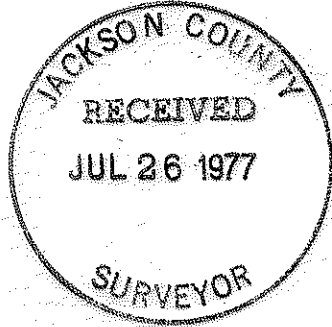

REGISTERED
PROFESSIONAL
LAND SURVEYOR

Edward A. McGinty

OREGON
EDWARD A. MCGINTY
301

SURVEY IN BLK. 7 PIERCE SUB-D, CITY OF MEDFORD
SW. 1/4, SEC. 21, T. 37 S., R. 1 W., WM.

FOR JACK SKAGGS
73-21-2

BY EDWARD, MC GINTY
MEDFORD, OREGON
APRIL 1977

SCALE 1" = 50'
O = 5/8" I. PIN

6862

521.37 1W (74.200)

6862

SURVEY NO.

0361

SURVEY NARRATIVE TO COMPLY WITH O.R.S. 209-250

Survey for: Jack Skaggs 73-21-2

Survey by: Edward A. McGinty, R.S.
Medford, Oregon
April, 1977

Basis of Bearing: Survey No. 5780

Location: City of Medford
SW. 1/4 of Sec. 21, T37S, R2S. WM
Jackson County, Oregon

Precedence of Survey:

Surveyed tract and prepared description, setting 5/8 X 24 ins. iron pins,
set approx. flush with the surface.

Survey control along Spring St. was determined from previous Survey No.
5780.



REGISTERED
PROFESSIONAL

Edward A. McGinty 4/24/77