

6960

SURVEY NARRATIVE & PLAT TO COMPLY WITH PARAGRAPH 209.250, OREGON REVISED STATUTES

Survey for: Ralph B. Leiby
43345 Highway 62
Prospect, Oregon 97536

Purpose: To separate the tract shown.
Procedure: EDM control survey.


Fd. Sec. cor.
1" iron pipe
with expander

Survey by : Charles H. Hurst
304 South Holly
Medford, Oregon 97501

SURVEY IN GOV'T. LOT 2, SECTION 1,
T. 33 S., R. 2 E., W.M.,
JACKSON COUNTY, OREGON.

Fd. 4 1/2" Dia. Steel Fence D.R. 373-177
Post Mkd. "Prop. Cor. No. 6"
with "+" on top

SCALE: 1" = 100'

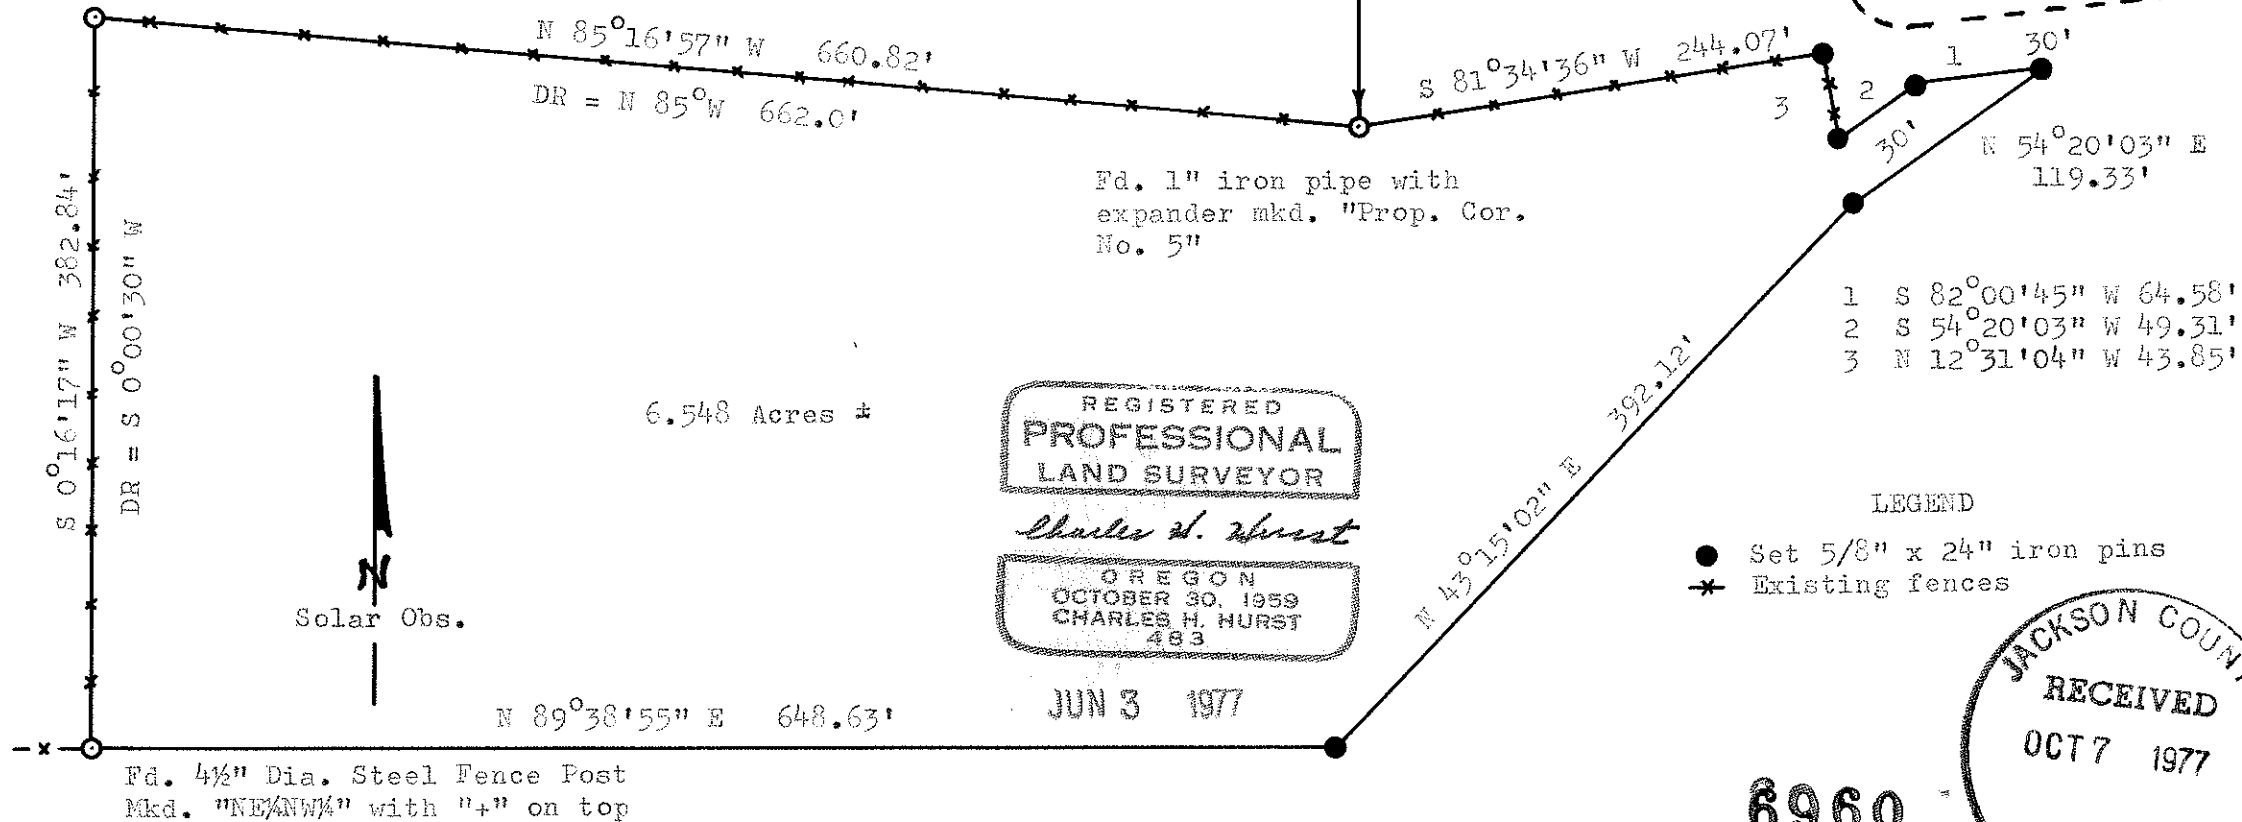

REGISTERED
PROFESSIONAL
LAND SURVEYOR

Charles H. Hurst

OREGON
OCTOBER 30, 1959
CHARLES H. HURST
483

JUN 3 1977

LEGEND

- Set 5/8" x 24" iron pins
- * Existing fences

JACKSON COUNTY
RECEIVED
OCT 7 1977
SURVEYOR

6960

S1 335 2E