

MAP OF SURVEY

LOCATED IN
D.L.C. NO. 48 IN SEC. 31, TWP 38S., R. 1 E.W.M.
JACKSON COUNTY OREGON
FOR

STEVEN SHAPIRO & DUANE F. SMITH

EVERETT L. SWAIN, R.L.S.

ASHLAND, OREGON


SCALE: 1" = 100'

FEBRUARY 26, 1977

BASIS OF BEARING:

N.O.A.A. TRUE BEARING AT N-S.C. OF SEC. 31

- FOUND MONUMENTS AS SHOWN
- SET 1/2 x 24 INCH IRON PIN TAGGED R.L.S. 759

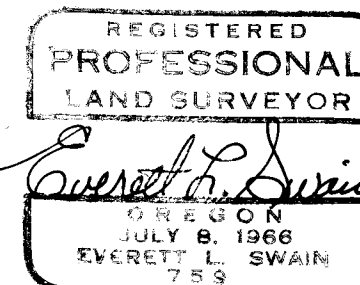

SURVEY NO. 6967

SURVEY NARRATIVE TO COMPLY WITH PARAGRAPH 209.250
OREGON REVISED STATUTES

SURVEY FOR: Steven Shapiro
564 Ashland Street
Ashland, Oregon 97520

Duane F. Smith
611 Siskiyou Boulevard
Ashland, Oregon 97520

LOCATION: Situated in Donation Land Claim No. 48, in Section 31, Township 38 South, Range 1 East of the Willamette Base and Meridian, Jackson County, Oregon.

PURPOSE: To survey, monument and prepare a legal description of a parcel of land contained within the clients ownership as per instructions.

PROCEDURE: From control established by this office, proceeded to relocate monumentation along the relocated Highway No. 99, Recorded Surveys No. 1548 and 2143 and tie the re-established Southwest corner of Donation Land Claim No. 48. With this information tied to the previously established control, proceeded to survey and monument the parcel of land as shown on the accompanying map.

Everett L. Swain
Professional Land Surveyor
Ashland, Oregon

