6980

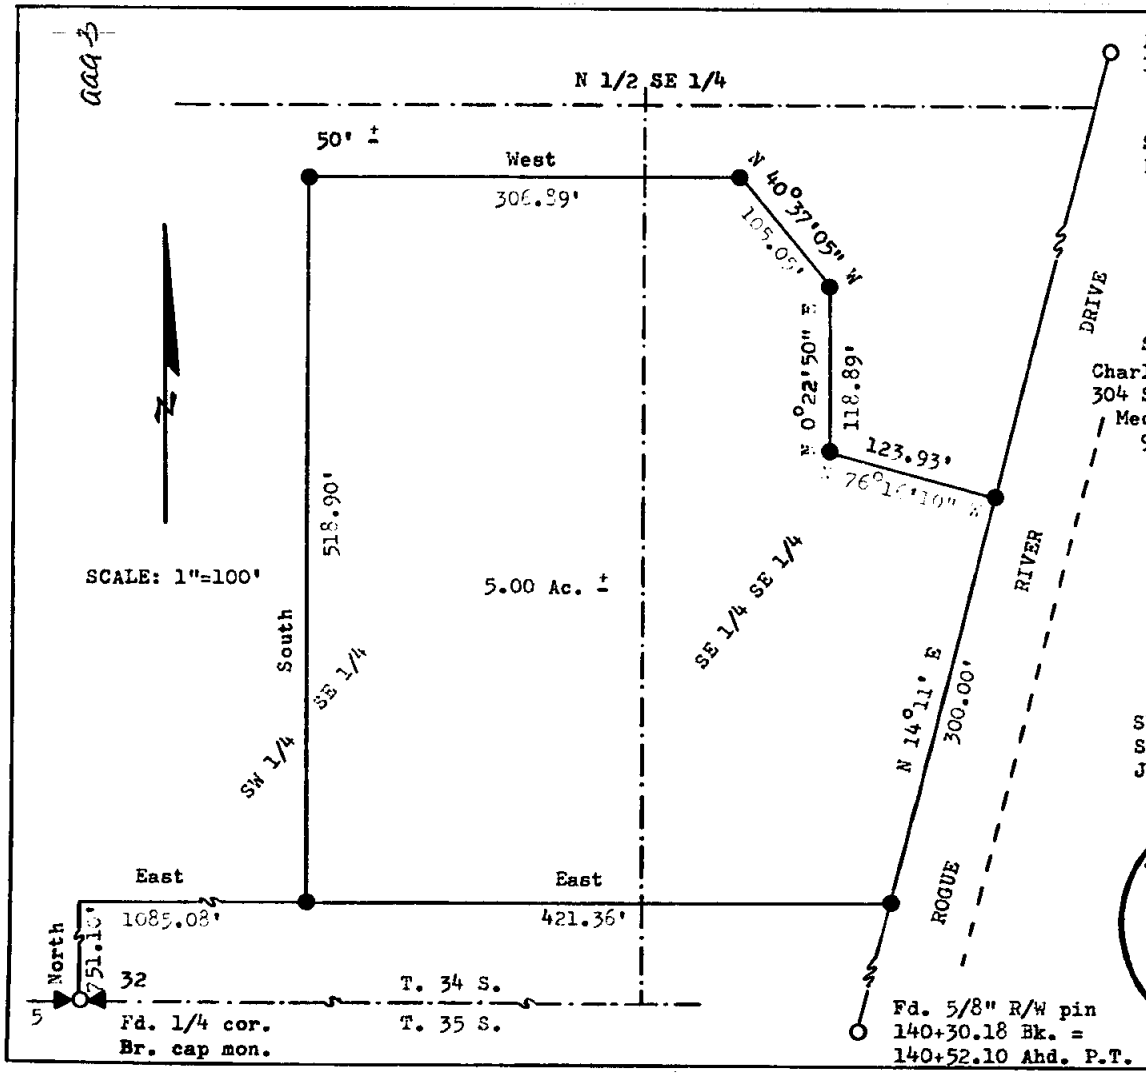

SCALE: 1"=100'

SURVEY PLAT AND NARRATIVE TO COMPLY WITH PARAGRAPH 209.250, OREGON REV. STATUTES.

FOR
JOHN K. COLEMAN
P.O. Box 1151
Shady Cove, Ore.
97539

SURVEY BY:
Charles H. Hurst
304 South Holly
Medford, Ore.
97501

LEGEND
● Set 5/8"x24" iron pins

MERIDIAN: Based on County road record
PURPOSE : To separate the tract shown

PROCEDURE

Survey control by theodolite and Electronic Distance Meas. Equipment. North boundary of tract established per client's instructions.

SURVEY SITUATE IN THE S 1/2 SE 1/4 OF SECTION 32, T. 34 S., R. 1 W., W.M., JACKSON COUNTY, OREGON.

JACKSON COUNTY
RECEIVED
OCT 25 1977
SURVEYOR

REGISTERED
PROFESSIONAL
LAND SURVEYOR
Charles H. Hurst
OREGON
OCTOBER 30, 1959
CHARLES H. HURST
483

SEP 28 1977

S32 34 1W 6980 (T.L. 1600)