
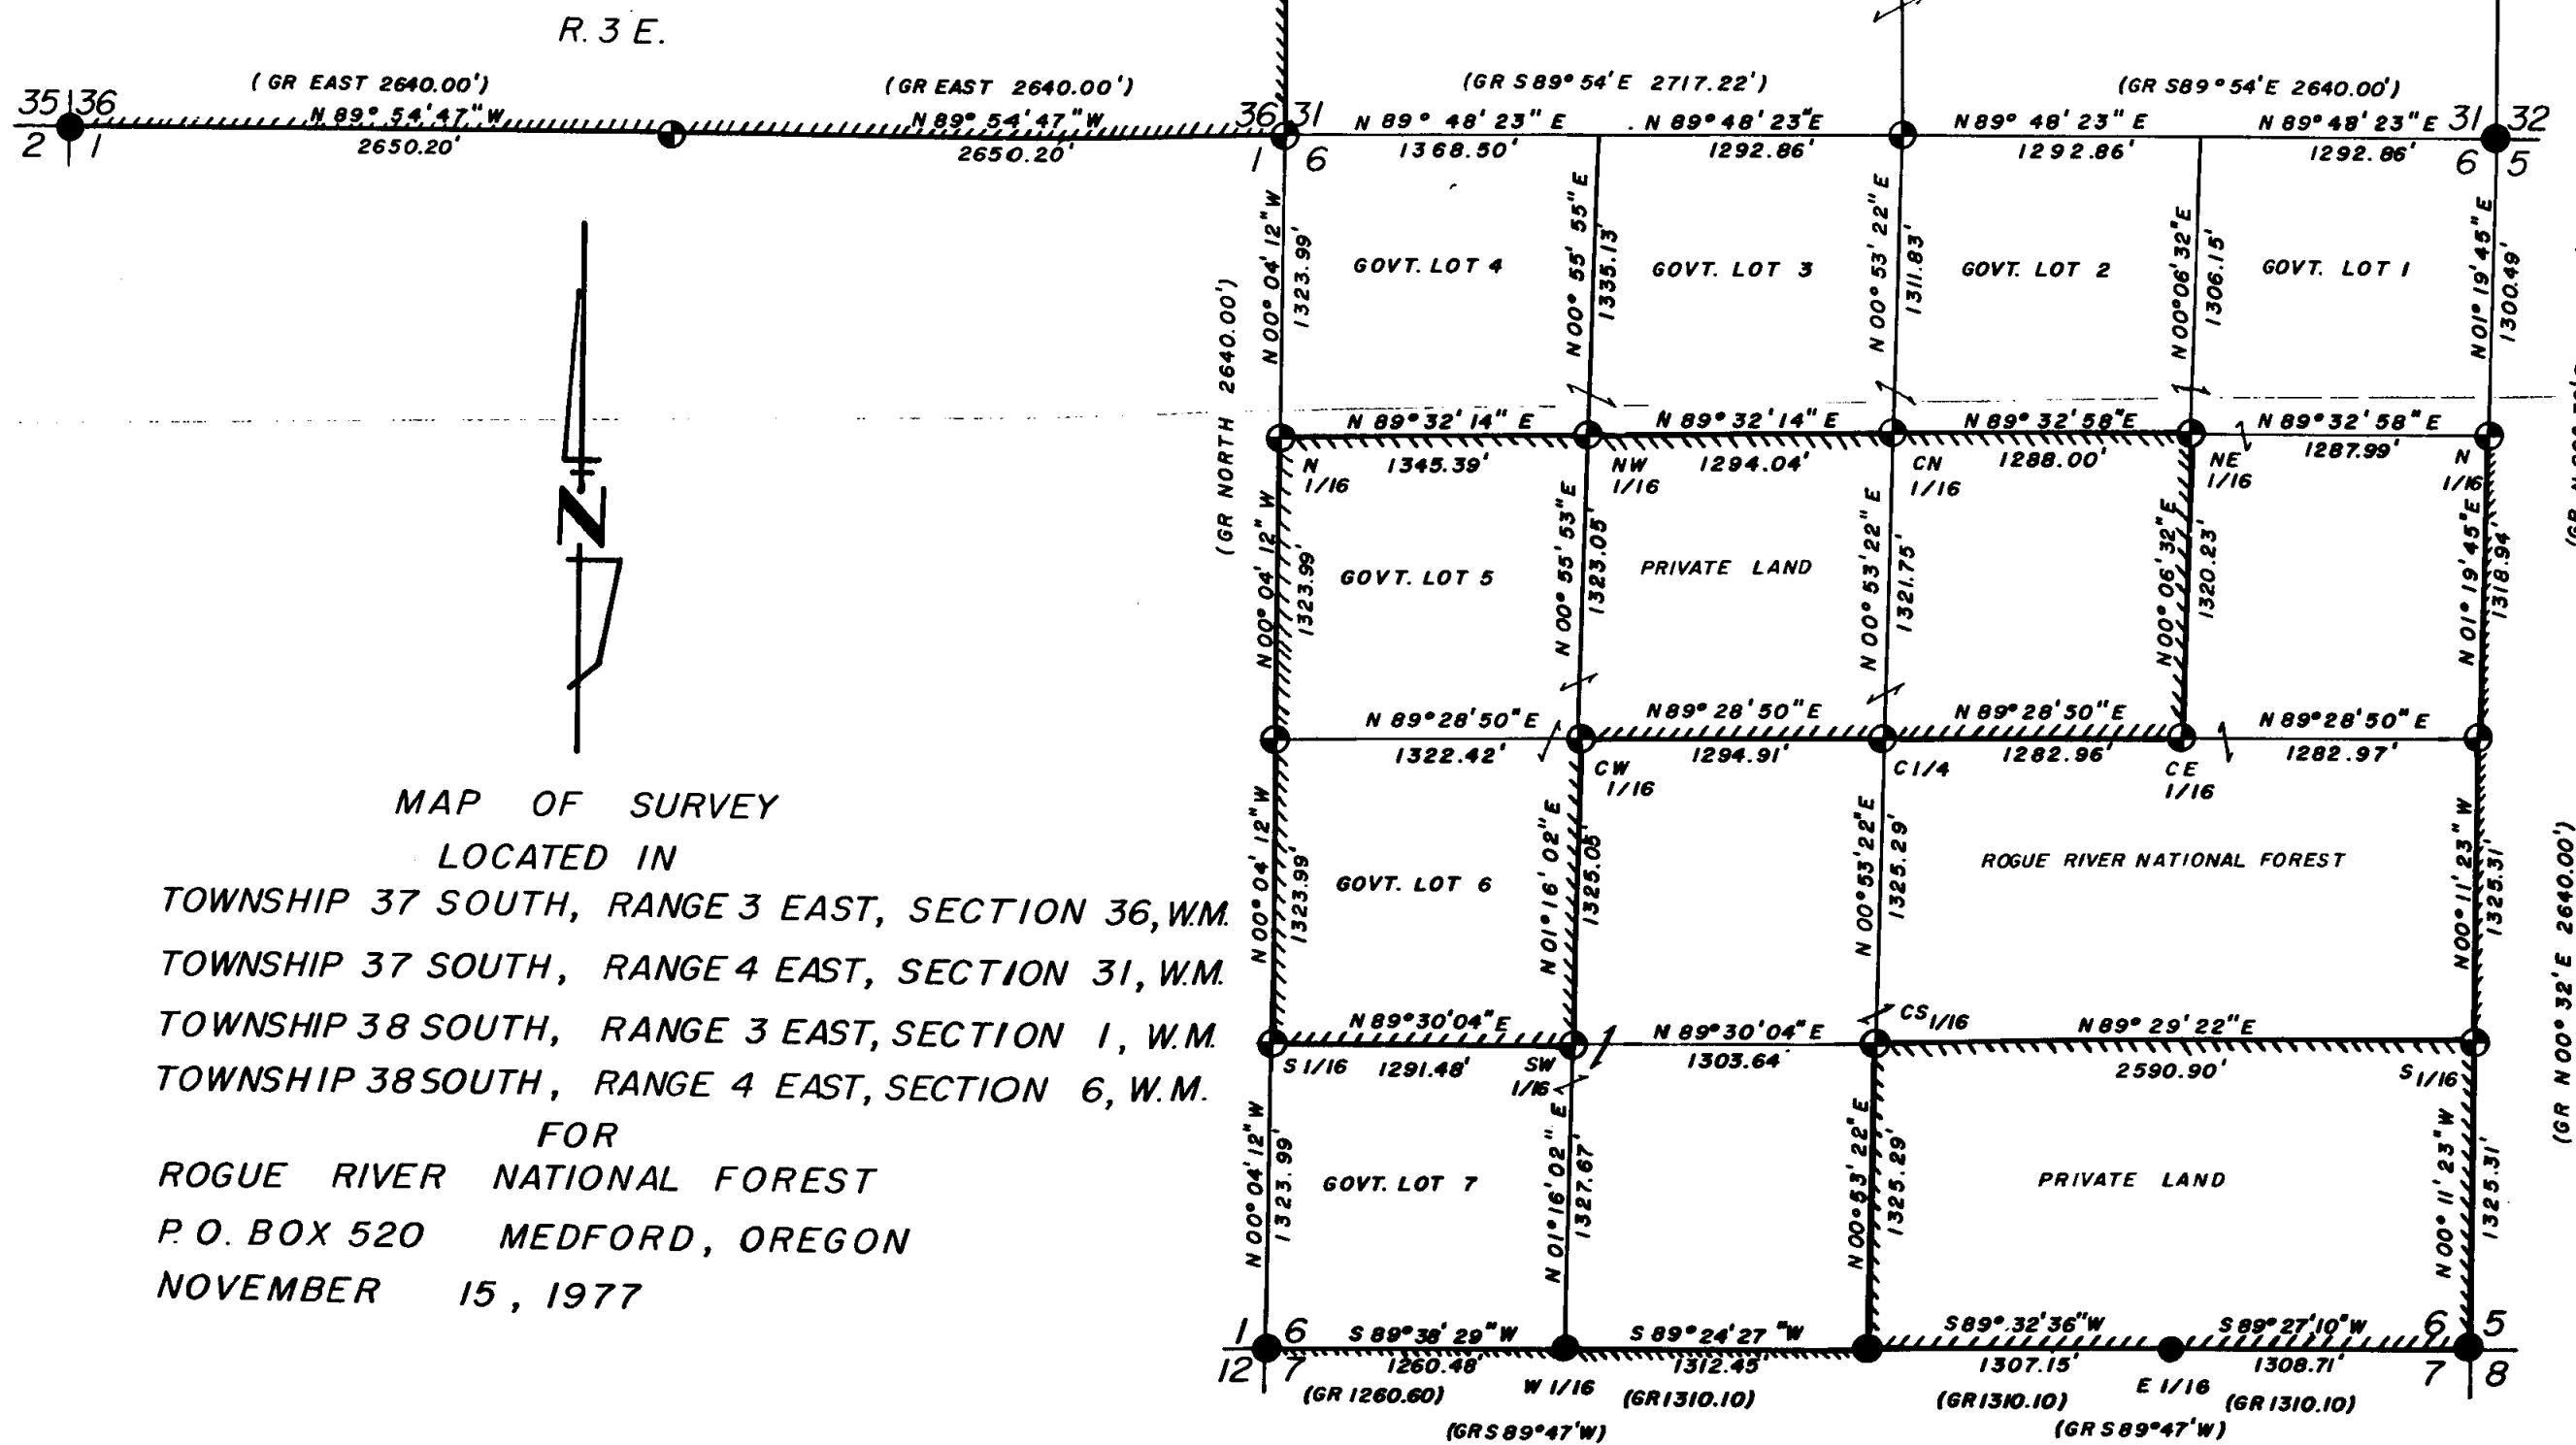


LEGEND

- FOUND STANDARD B.L.M. & G.L.O. MONUMENT
- ◆ FOUND JACKSON-COUNTY SURVEYOR MONUMENT
- ⊕ SET 2 1/2" DIA. X 30" LG. GAL. IRON POST WITH 2 1/2" DIA. BRASS CAP - MONUMENT



▬▬▬ NATIONAL FOREST BOUNDARY
BASIS OF BEARING — SOLAR OBSERVATION

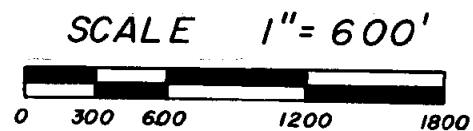

MAP OF SURVEY
LOCATED IN
TOWNSHIP 37 SOUTH, RANGE 3 EAST, SECTION 36, W.M.
TOWNSHIP 37 SOUTH, RANGE 4 EAST, SECTION 31, W.M.
TOWNSHIP 38 SOUTH, RANGE 3 EAST, SECTION 1, W.M.
TOWNSHIP 38 SOUTH, RANGE 4 EAST, SECTION 6, W.M.
FOR
ROGUE RIVER NATIONAL FOREST
P.O. BOX 520 MEDFORD, OREGON
NOVEMBER 15, 1977

CERTIFICATE OF SURVEY

I, HAROLD L. CENTER REGISTRATION N° 1071
REGISTERED PROFESSIONAL LAND SURVEYOR
STATE OF OREGON, HEREBY CERTIFY THAT
THIS MAP CORRECTLY REPRESENTS A SURVEY
MADE BY ME OR UNDER MY DIRECTION IN
CONFORMANCE WITH THE LAWS OF THE
STATE OF OREGON, AT THE REQUEST OF
THE U.S. FOREST SERVICE.

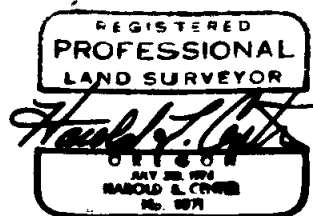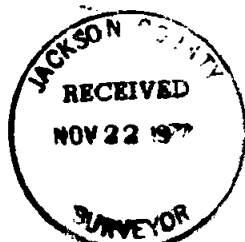


DD 7010

U.S. DEPARTMENT OF AGRICULTURE	
FOREST SERVICE	
REGION 6	ROGUE RIVER NAT FOREST
DEPENDENT RESURVEY AND SECTION SUBDIVISION OF NATIONAL FOREST BOUNDARIES	
SURVEYED <i>[Signature]</i>	DATE 11-77
REVIEWED <i>[Signature]</i>	DATE 11-77
APPROVED <i>[Signature]</i>	DATE 11-77

Centereast one-sixteenth corner Section 6, Township 38 South, Range 4 East, Willamette Meridian.

At the corner position I set a 2 1/2 inch diameter galvanized iron post with a 2 1/2 inch diameter brass cap marked:

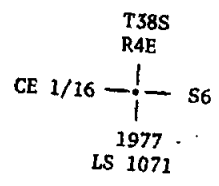


From which the following references:

A fir 12 inches in diameter bears N10° 00' E, 26.90 feet distance, scribed CE 1/16 S6 LS 1071 BT.

A fir 15 inches in diameter bears S86° 00' W, 53.60 feet distance, scribed CE 1/16 S6 LS 1071 BT.

HAROLD L. CENTER
Registered Professional Surveyor
Oregon Certificate No. 1071

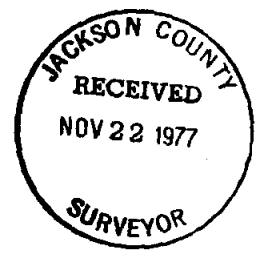

At the corner position I set a 2 1/2 inch diameter galvanized iron post with 2 1/2 inch diameter brass cap marked:

T38S
R4E
|
CW 1/16 ——— S6
|
1977
LS 1071

From which the following references:

A fir 14 inches diameter bears S21° 27' E, 7.70 feet distance, scribed CW 1/16 S6 LS 1071 BT.

A fir 19 inches in diameter bears N56° 56' E, 49.20 distance, scribed CW 1/16 S6 LS 1071 BT.

Centernorth one-sixteenth corner Section 6, Township 38 South, Range 4 East, Willamette Meridian.

At the corner location I set a 2 1/2 inch diameter galvanized iron post with 2 1/2 inch diameter brass cap marked:

T38S
R4E
|
CN 1/16 ——— S6
|
1977
LS 1071

From which the following references:

A fir 15 inches in diameter bears N65° 05' W, 38.90 feet distance, scribed CN 1/16 S6 LS 1071 BT.

A fir 12 inches in diameter bears S22° 00' E, 45.20 feet distance, scribed CN 1/16 S6 LS 1071 BT.

Northeast one-sixteenth corner Section 6, Township 38 South, Range 4 East, Willamette Meridian.

At the corner position I set a 2 1/2 inch diameter galvanized iron post with 2 1/2 inch diameter brass cap marked:

T38S
R4E
|
NE 1/16 ——— S6
|
1977
LS 1071

From which the following references:

A fir 8 inches in diameter bears N24° 03' E, 26.70 feet distance, scribed NE 1/16 S6 LS 1071 BT.

A fir 8 inches in diameter bears S44° 56' E, 21.80 feet distance, scribed NE 1/16 S6 LS 1071 BT.

From which the following references:

A fir 20 inches in diameter bears $S00^{\circ} 54' E$, 24.00 feet distance, scribed C1/4 S6 LS 1071 BT.

A fir 14 inches in diameter bears $N07^{\circ} 23' E$, 35.30 feet distance, scribed C1/4 S6 LS 1071 BT.

South one-sixteenth corner common to Sections 6 and 5, Township 38 South, Range 4 East, Willamette Meridian.

At the corner position I set a 2 1/2 inch diameter galvanized iron post with 2 1/2 inch diameter brass cap marked:

T38S
R4E
S1/16 S6 — | — S5
1977
LS 1071

From which the following references:

A fir 20 inches in diameter bears $N38^{\circ} 05' E$, 38.30 feet distance, scribed S1/16 S5 LS 1071 BT.

A fir 15 inches in diameter bears $S32^{\circ} 05' W$, 82.30 feet distance, scribed S1/16 S6, LS 1071 BT.

Northwest one-sixteenth corner Section 6, Township 38 South, Range 4 East, Willamette Meridian.

At the corner position I set a 2 1/2 inch diameter galvanized iron post with 2 1/2 inch diameter brass cap marked:

T38S
R4E
NW 1/16 — | — S6
1977
LS 1071

From which the following references:

A fir 13 inches in diameter bears $N55^{\circ} 27' W$, 31.70 feet distance, scribed NW 1/16 S6 LS 1071 BT.

A fir 9 inches in diameter bears $N70^{\circ} 39' E$, 20.10 feet distance, scribed NW 1/16 S6 LS 1071 BT.


Centerwest one-sixteenth corner Section 6, Township 38 South, Range 4 East, Willamette Meridian.

A fir 7 inches in diameter bears S30° 27' E, 8.70 feet distance, scribed SW 1/16 S6 LS 1071 BT.

A yew 18 inches in diameter bears N28° 09' E, 28.10 feet distance, scribed SW 1/16 S6 LS 1071 BT.

Centersouth one-sixteenth corner Section 6, Township 38 South, Range 4 East, Willamette Meridian.

At the corner position I set a 2 1/2 inch diameter galvanized iron post with 2 1/2 inch diameter brass cap marked:

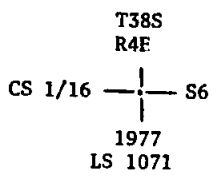


From which the following references:

A cedar 11 inches in diameter bears S37° 29' W, 33.00 feet distance, scribed CS 1/16 S6 LS 1071 BT.

A fir 22 inches in diameter bears N85° 18' W, 12.00 feet distance, scribed CS 1/16 S6 LS 1071 BT.

North one-sixteenth corner common to Sections 5 and 6, Township 38 South, Range 4 East, Willamette Meridian.

At the corner position I set a 2 1/2 inch diameter galvanized iron post with 2 1/2 inch diameter brass cap marked:

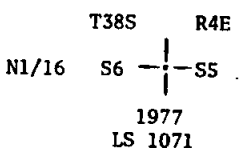


From which the following references:

A fir 18 inches in diameter bears S53° 09' E, 51.60 feet distance, scribed N1/16 S5 LS 1071 BT.


A fir 12 inches in diameter bears S20° 25' W, 61.50 feet distance, scribed N1/16 S6 LS 1071 BT.

Center one-quarter corner Section 6, Township 38 South, Range 4 East, Willamette Meridian.

At the corner position I set a 2 1/2 inch diameter galvanized iron post with 2 1/2 inch diameter brass cap marked:

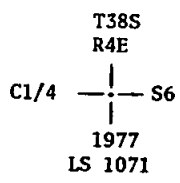

At the corner position I set a 2 1/2 inch diameter galvanized iron post with 2 1/2 inch diameter brass cap marked:

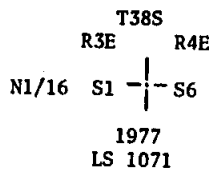


From which the following references:

A fir 7 inches in diameter bears N29° 57' W, 45.10 feet distance, scribed N1/16 S1 LS 1071 BT.

A fir 13 inches in diameter bears N84° 03' E, 7.30 feet distance, scribed N1/16 S6 LS 1071 BT.

South one-sixteenth corner common to Section 1, Township 38 South, Range 3 East and Section 6, Township 38 South, Range 4 East, Willamette Meridian.

At the corner position I set a 2 1/2 inch diameter galvanized iron post with 2 1/2 inch diameter brass cap marked:

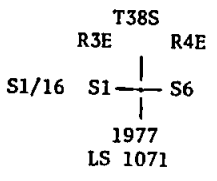

From which the following references:


A cedar 9 inches in diameter bears N59° 19' E, 27.50 feet distance, scribed S1/16 S6 LS 1071 BT.

A fir 22 inches in diameter bears S09° 01' E, 56.60 feet distance, scribed S1/16 S6 LS 1071 BT.

A cedar 6 inches in diameter bears N46° 44' W, 75.00 feet distance, scribed S1/16 S1 LS 1071 BT.

Southwest one-sixteenth corner, Section 6, Township 38 South, Range 4 East, Willamette Meridian.

At the corner I set a 2 1/2 inch diameter galvanized iron post with 2 1/2 inch diameter brass cap marked:

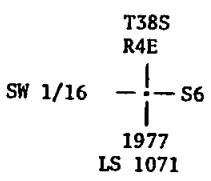

From which the following references:

This corner had been searched for without success on several occasions by Forest Service personnel and County Surveyor Deputies. A proportional position was computed from survey control and the following evidence was recovered:

A lodgepole pine 15 inches in diameter bears N60° 46' E, 11.50 feet distance to base. This tree is dead and down; I removed a section from tree and found legible scribe 1/4 S BT. At approximate corner position I dug below the ground surface and found a mound of stone. I accepted the tree and stone mound as that set for the original and in the position occupied by the stone mound I set a 2 1/2 inch diameter galvanized iron post with 2 1/2 inch diameter brass cap marked:

T38S | R4E
1/4 S6 | S5
1977
LS 1071

From which the following references:

A fir 12 inches in diameter bears N69° 38' W, 27.20 feet distance, scribed 1/4 S6 LS 1071 BT.

A fir 11 inches in diameter bears N18° 31' E, 25.60 feet distance, scribed 1/4 S5 LS 1071 BT.

A lodgepole pine 15 inches in diameter bears N60° 40' E, 11.50 feet distance, scribe visible 1/4S BT. Tree dead and down.

One quarter corner common to Section 1, Township 38 South, Range 3 East and Section 6, Township 38 South, Range 4 East, Willamette Meridian.

At the proportional corner position I set a 2 1/2 inch diameter galvanized iron post with 2 1/2 inch diameter brass cap marked:

T38S
R3E | R4E
1/4 S1 S6
1977
LS 1071

From which the following references:

A fir 20 inches in diameter bears S87° 25' W, 18.50 feet distance, scribed 1/4 S1 LS 1071 BT.

A fir 18 inches in diameter bears S49° 32' E, 63.50 feet distance scribed 1/4 S6 LS 1071 BT.

North one-sixteenth corner common to Section 1, Township 38 South, Range 3 East and Section 6, Township 38 South, Range 4 East, Willamette Meridian.


From which the following references:

A fir 11 inches in diameter bears S34° 29' E, 23.60 feet distance, scribed CN 1/16 S31 LS 1071 BT.

A fir 14 inches in diameter bears N43° 19' W, 33.00 feet distance, scribed CN 1/16 S31 LS 1071 BT.

North one-sixteenth corner common to Sections 31 and 32, Township 37 South, Range 4 East, Willamette Meridian.

At the corner location I set a 2 1/2 inch diameter galvanized iron post with 2 1/2 inch diameter brass cap marked:

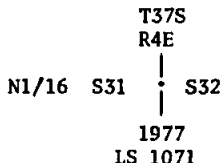


From which the following references:

A fir 14 inches in diameter bears S17° 44' W, 32.00 feet distance, scribed N 1/16 S31 LS 1071 BT.

A fir 13 inches in diameter bears N50° 10' E, 21.50 feet distance, scribed N1/16 S32 LS 1071 BT.

One quarter corner common to Section 36, Township 37 South, Range 3 East, and Section 1, Township 38 South, Range 4 East, Willamette Meridian.

At the portion corner position I set a 2 1/2 inch diameter galvanized iron post with 2 1/2 inch diameter brass cap marked:

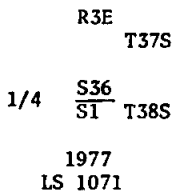

From which the following references:

A fir 12 inches in diameter bears N28° 51' W, 22.50 feet distance, scribed 1/4 S36 LS 1071 BT.

A cedar 23 inches in diameter bears S35° 27' E, 31.00 feet distance, scribed 1/4 S1 LS 1071 BT.

One quarter corner common to Sections 5 and 6, Township 38 South, Range 4 East, Willamette Meridian.

A fir 15 inches in diameter bears N81° 15' E, 4.90 feet distance.
A partially opened face was present when I first visited this
corner. I opened remainder of tree and found scribing 1/4 S RS BT.
(Tree believed to be marked by Ray Schindler, former Forest Service
employee, circa 1910-1920.)

One quarter corner common to Section 31, Township 37 South, Range 4 East and
Section 6, Township 38 South, Range 4 East, Willamette Meridian.

At the proportioned corner position I set a 2 1/2 inch diameter galvanized
iron post with 2 1/2 inch diameter brass cap marked:

R4E

1/4	S31		T37S
	S6		T38S

1977
LS 1071

From which the following references:

A fir 10 inches in diameter bears N31° 05' E, 14.60 feet distance,
scribed 1/4 S31 LS 1071 BT.

A cedar 26 inches in diameter bears S67° 03' E, 40.20 feet distance,
scribed 1/4 S6 LS 1071 BT.

Center one-quarter corner Section 31, Township 37 South, Range 4 East,
Willamette Meridian.

At the corner position I set a 2 1/2 inch diameter galvanized iron post
with 2 1/2 inch diameter brass cap marked:

T37S
R4E
C1/4 -| -S32

1977
LS 1071

From which the following references:

A fir 9 inches in diameter bears S55° 17' E, 7.30 feet distance,
scribed C1/4 S31 LS 1071 BT.

A fir 14 inches in diameter bears N11° 50' E, 38.00 feet distance,
scribed C1/4 S31 LS 1071 BT.

Centernorth one-sixteenth corner Section 31, Township 37 South, Range 4 East,
Willamette Meridian.

At the corner location I set a 2 1/2 inch diameter galvanized iron post with
2 1/2 inch diameter brass cap marked:

T37S
R4E
CN 1/6 -| -S31

1977
LS 1071

From which the following references:

A fir stump 24 inches in diameter bears S03° 16' W, 42.40 feet distance, found bits of scribing - not legible.

A fir 14 inches in diameter bears S14° 42' W, 5.40 feet distance, scribed T38S R3E S1 LS 1071 BT.

A fir 7 inches in diameter bears N57° 28' W, 16.20 feet distance, scribed T37S R3E S36 LS 1071 BT.

A fir 32 inches in diameter bears N05° 48' W, 19.30 feet distance, found no scribing; however, Forest Service employees and County Surveyor Deputies Report to have recovered scribing in this tree at a prior date.

A fir 8 inches in diameter bears N13° 41' E, 11.20 feet distance, scribed T37S R4E S31 LS 1071 BT.

A fir, badly decayed, estimated to be 36-40 inches in diameter. Bears N55° 11' E, 31.90 feet distance to center or rotted remains, found identifiable scribe 'T' along with other axed out scribe in remaining face.

A fir 8 inches in diameter bears N68° 41' E, 22.20 feet distance, scribed T37S R4E S31 LS 1071 BT.

A fir 9 inches in diameter bears S62° 28' W, 27.60 feet distance, scribed T38S R4E S6 LS 1071 BT.

One quarter corner common to Section 36, Township 37 South, Range 3 East, and Section 31, Township 38 South, Range 4 East, Willamette Meridian.

At the corner location I found a stone 6" x 8" x 24" with an 'X' and the letters SLM marked on the stone. In its location I set a 2 1/2 inch diameter galvanized iron post with 2 1/2 inch diameter brass cap marked:

T37S
R3E R4E

1/4 S36 S31

1977
LS 1071

From which the following references:

A fir 28 inches in diameter bears S31° 48' W, 11.40 feet distance. Tree has a previously opened face, I opened remainder of face and found legible scribe mark S and other illegible scribe.

A fir 18 inches in diameter bears S67° 41' W, 44.20 feet distance, scribed 1/4 S36 LS 1071 BT.

A fir 18 inches in diameter bears N46° 19' E, 45.30 feet distance, scribed 1/4 S31 LS 1071 BT.

At each of the above corners evidence was found indicating the presence of a corner. Each corner had a stone monument marked with an 'X' and the letters SLM (Section Line Marker) with various reference trees. At each corner where the evidence was found I was unable to locate any evidence traceable to the original establishment of this corner. These corners were tied to my random traverse and evaluated by proportional measurement.

Several steps were taken in an attempt to prove or disprove the evidence found at each respective corner with the following conclusions:


1. The stone monuments found were of sufficient size and purposely marked to indicate the presence of a corner.
2. Sufficient witness trees had been marked to reference the stones.
3. The portional position calculation closely verifys the position of each corner.
4. A move to the portional position would cause a dog leg distortion to the bearings of the lines running north and south from the corner.
5. Conversation with adjacent landowners reflects the use of the stone monuments for the respective corner for over 30 years. Records at Boise Cascade Corporation were observed and indicate these corners were used to establish cutting lines in several directions from these corners indicating the corners had been accepted as a local point of control for many years.
6. I located blazed lines leading to both corners. These lines varied in age by growth ring count from 17 to 60 plus years.
7. No other eivdence could be recovered to disprove the corners.

In view of these facts I elected to accept the positions of the found stones and monument corner positions as follows:

Township corner common to Section 36, Township 37 South, Range 3 East and Section 31, Township 37 South, Range 4 East and Section 1, Township 38 South, Range 3 East and Section 6, Township 38 South, Range 4 East, Willamette Meridian.

At the corner location I found a large basalt stone (estimated size 2' x 2' x 3 1/2') with an 'X' on top and the letters SLM on the south face.

In its position I set a 2 1/2 inch diameter galvanized iron post with 2 1/2 inch diameter brass cap marked:

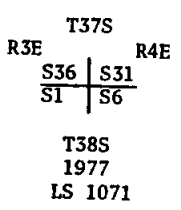

Reset found stone to north with 'X' at 1.30 feet distance.

At the corner location I found a Standard General Land Office Monument with 2 1/2 inch diameter brass cap marked:

General Land Office
Unlawful to Disturb
T38S R4E
E 1/16 $\frac{S6}{S7}$

1957

From which the following references:

A fir 17 inches in diameter bears S30° 28' E, 20.00 feet distance, healed scar.

A fir 26 inches in diameter bears N37° 02' E, 42.80 feet distance, healed scar.

West one-sixteenth corner common to Sections 6 and 7, Township 38 South, Range 4 East, Willamette Meridian.

At the corner location I found a Standard General Land Office Monument with 2 1/2 inch diameter brass cap marked:

General Land Office
Unlawful to Disturb
T38S R4E
W 1/16 $\frac{S6}{S7}$

1957

From which the following references:

A fir 16 inches in diameter bears N33° 38' W, 16.50 feet distance, healed scar.

A fir 21 inches in diameter bears S02° 10' W, 13.00 feet distance, healed scar.

Corners established this survey:

In the execution of this survey it became necessary to reestablish the Township Corner common to Section 36, Township 37 South, Range 3 East; Section 31, Township 37 South, Range 4 East; Section 1, Township 38 South, Range 3 East and Section 6, Township 38 South, Range 4 East, Willamette Meridian,

and

The one quarter corner common to Section 36, Township 37 South, Range 3 East and Section 31, Township 37 South, Range 4 East, Willamette Meridian.

At the corner location I found a standard General Land Office monument with 2 1/2 inch diameter brass cap marked:

U.S. General Land Office
 Unlawful to Disturb
 T38S R4E

S6	S5
S7	S8

1957

From which the following references:

A fir 19 inches in diameter bears S19° 06' W, 39.70 feet distance, healed scar.

A fir 25 inches in diameter bears N43° 03' W, 51.34 feet distance, scribe visible.

A fir 24 inches in diameter bears N13° 49' E, 108.38 feet distance, scribe visible.

A fir dead and down bears S71° 50' E, 222.00 feet distance, scribe visible.

One quarter corner common to Sections 6 and 7, Township 38 South, Range 4 East, Willamette Meridian.

At the corner location I found a standard General Land Office monument with 2 1/2 inch diameter brass cap marked:

General Land Office
 Unlawful to Disturb
 T38S R4E

1/4 $\frac{S6}{S7}$

1957

From which the following references:

A fir 15 inches in diameter bears S54° 51' W, 16.85 feet distance, healed scar.

A fir 13 inches in diameter bears N03° 47' W, 16.44 feet distance, healed scar.

East one-sixteenth corner common to Sections 6 and 7, Township 38 South, Range 4 East, Willamette Meridian.

At the corner location I found a 1 inch diameter galvanized iron post with 2 1/2 inch diameter brass cap marked:

Jackson County Surveyor
T37S R4E

1/4
S31 | S32
1974

From which the following references:

A yew 12 inches in diameter bears N02° 12' E, 25.67 feet distance, scribed CS BT.

A fir 14 inches in diameter bears S67° 59' E, 30.38 feet distance, scribe visible.

A yew 6 inches in diameter bears S84° 59' W, 11.40 feet distance, scribed CS BT.

A fir 15 inches in diameter bears N65° 41' W, 15.46 feet distance, healed scar.

Section corner common to Sections 31 and 32, Township 37 South, Range 4 East and Sections 5 and 6, Township 38 South, Range 4 East, Willamette Meridian.

At the corner location I found a standard BLM monument marked:

U.S. Dept. of Interior
Cadastral Surveys
Unlawful to Disturb

T37S R4E
S31 | S32
S6 | S5
T38S R4E
1973

From which the following references:

A fir 52 inches in diameter bears S36° 04' W, 27.99 feet distance, scribe visible.

A fir 41 inches in diameter bears N84° 34' W, 52.04 feet distance, scribe visible.

A fir 28 inches in diameter bears N84° 57' E, 35.75 feet distance, healed scar.

A fir 32 inches in diameter bears S15° 58' E, 22.87 feet distance, healed scar.

Section corner common to Sections 5, 6, 7 and 8, Township 38 South, Range 4 East, Willamette Meridian.

One quarter corner common to Sections 30 and 31, Township 37 South, Range 4 East, Willamette Meridian.

At the corner location I found a 1 inch diameter galvanized iron post with 2 1/2 inch diameter brass cap marked:

Jackson County Surveyor
T37S R4E
1/4 S30
S31

C.S.
1974

From which the following references:

A fir 17 inches in diameter bears N37° 37' W, 28.80 feet distance, scribing visible.

A fir 13 inches in diameter bears N16° 01' E, 12.10 feet distance, scribing visible.

A fir 13 inches in diameter bears S05° 17' W, 65.53 feet distance, scribing visible.

The Section corner common to Sections 29, 30, 31 and 32, Township 37 South, Range 4 East, Willamette Meridian.

At the corner location I found a 1 inch diameter galvanized iron post with 2 1/2 inch diameter brass cap marked:

Jackson County Surveyor
T37S R4E
S30 | S29
S31 | S32

1974

From which the following references:

A pine 18 inches in diameter bears N08° 57' W, 250.30 feet distance, scribed CS BT.

A pine 15 inches in diameter bears N21° 08' E, 165.22 feet distance, scribe visible. This tree now dead.

A pine 23 inches in diameter bears N57° 32' E, 161.03 feet distance, scribed CS BT.

A fir 19 inches in diameter bears S11° 23' E, 268.97 feet distance, scribed CS BT.

A fir 24 inches in diameter bears S18° 04' W, 293.13 feet distance, scribed CS BT.

One quarter corner common to Sections 31 and 32, Township 37 South, Range 4 East, Willamette Meridian.

At this corner I found a 1 inch diameter galvanized iron post with 2 1/2 inch diameter brass cap marked:

Jackson County Surveyor
T37S

R3E

R4E

WC

S25	S30
S36	S31

C.S.
1974

From which the following references:

An oak 8 inches in diameter bears S18° 02' W, 178.70 feet distance, scribed CS BT.

A fir 19 inches in diameter bears S73° 07' E, 85.47 feet distance, scribed CS BT.

A fir 46 inches in diameter bears S43° 41' E, 77.61 feet distance. Healed scar shows signs of recent opening by chain saw.

The section corner common to Sections 35 and 36, Township 37 South, Range 3 East and Sections 1 and 2, Township 38 South, Range 3 East, Willamette Meridian.

At the corner location I found a standard General Land Office monument with 2 1/2 inch diameter brass cap marked:

U.S. General Land Office
Unlawful to Disturb
T37S R3E

S35	S36
S2	S1

T38S R3E
1961

From which the following references:

A fir 24 inches in diameter bears N27° 33' W, 39.00 feet distance, scribe visible.

A fir 20 inches in diameter bears N22° 46' E, 23.40 feet distance, scribe visible.

A fir 13 inches in diameter bears N27° 40' E, 26.00 feet distance, scribe visible.

A fir 23 inches in diameter bears S25° 05' E, 29.70 feet distance, scribe visible.

A fir 23 inches in diameter bears S73° 45' W, 13.90 feet distance, scribe visible.

SURVEY NARRATIVE TO COMPLY WITH
PARAGRAPH 209.250 OREGON REVISED STATUTES

Survey for: Rogue River National Forest
P. O. Box 520
Medford, Oregon 97501

Location: Section 36, Township 37 South, Range 3
East; Section 1, Township 38 South, Range
3 East; Section 31, Township 37 South,
Range 4 East and Section 6, Township 38
South, Range 4 East, Willamette Meridian,
Jackson County, Oregon.

Purpose: To establish National Forest boundaries
within the above described ownership.

Procedure: A closed traverse was ran tying corners
around the perimeters of Section 31 and
Section 6 with interior traverse lines run
tying to the perimeter traverse. From this
data true lines were computed and corners
were established at the locations as shown
on the attached map.

Corners Accepted For Control

Section corner common to Sections 1 and 12, Township 38 South, Range 3
East, and Sections 6 and 7, Township 38 South, Range 4 East, Willamette
Meridian.

At the corner location I found a standard General Land Office monument
with 2 1/2 inch diameter brass cap marked:

U. S. General Land Office
Unlawful to Disturb
T38S

R3E

R4E

S1	S6
S12	S7

1957

From which the following references:

A pine 25 inches in diameter bears N45° 03' E, 56.85 feet distance,
healed scar.

A pine 30 inches in diameter bears S53° 01' E, 18.06 feet distance,
scribe visible.

A fir 11 inches in diameter bears N53° 41' W, 45.50 feet distance,
healed scar.

A cedar 13 inches in diameter bears N23° 49' W, 64.79 feet distance,
tree dead, scribe visible.

Witness corner common to Section 36, Township 37 South, Range 3 East and
Section 31, Township 37 South, Range 4 East, Willamette Meridian.

SURVEY NARRATIVE TO COMPLY WITH
PARAGRAPH 209.250 OREGON REVISED STATUTES

Survey for: Rogue River National Forest
P. O. Box 520
Medford, Oregon 97501

Date: February 7, 1978

Location: Section 6, Township 38 South,
Range 4 East, Willemette Meridian,
Jackson County, Oregon.

Purpose: To correct a drafting error discovered
in original plat of Record Survey No. 7010.

Procedure: A review of the original plat revealed
a obvious error in the distance shown
north from the northwest one sixteenth
corner section 6. The distance should
be 1317.91 feet rather than the 1335.13
feet distance shown.

HAROLD L. CENTER
Registered Professional Land Surveyor
Oregon Certificate No. 1071

