


Fd. C.S. br. capped pipe
from which a 1/2" iron
pipe bears N 46° 38' E
0.25

B102



SCALE 1"=100'
Basis of Bearings
R.S. No. 3988

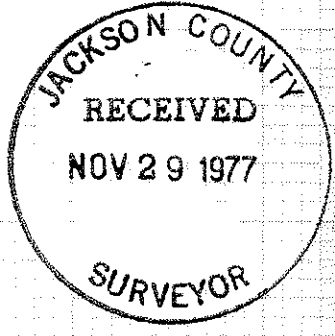

- = Fd. 5/8" I. Pin per R.S. 3988
- = Set 5/8" x 24" I. Pin

REGISTERED
**PROFESSIONAL
LAND SURVEYOR**
Geo. Burrell
OREGON
JULY 10, 1964
GEORGE R. BURRELL
638

MAP OF SURVEY
Located in Sec. 20, T36S, R3W
For: ROGER GASCON
By: Geo. Burrell, Surveyor
Nov. 1977

7014
S20 36 3W
(T.L. 2404
2414)

SURVEY NO. 70141

SURVEY NARRATIVE TO COMPLY WITH O.R.S. 209.250

FOR: Roger Gascon
545 Hodson Rd.
Gold Hill, Oregon

PURPOSE: To establish and monument a division line of record partitioning the clients property.

PROCEDURE: The monuments of recorded survey No. 3988 were found and held as control in as much as they control the original Hodson property partitions (except the exterior boundaries of section 20). Said record division line was established at record distance in latitude from the found monuments as shown on the accompanying map.

REGISTERED
PROFESSIONAL
LAND SURVEYOR

George R. Burrell

OREGON
JULY 10, 1964
GEORGE R. BURRELL
638

