APPROVAL:

Ashland Planning Commission — Date 11/11/78

M77-352

MINOR LAND PARTITION

LOCATED IN

LOTS 13, 14, 15, 16 & 17, BLK. "T" OF RAILROAD ADDITION
IN THE CITY OF ASHLAND & D.L.C. NO. 39 IN NE 1/4 OF SEC. 9, TWP. 39S., R. 1E.W.M.
JACKSON COUNTY OREGON

for

DON L. GREENE
P. O. BOX 516
ASHLAND, OREGON 97520

Filed for record this the 25 day of January 19 78 at 2:30 o'clock P.M. and recorded in Volume 2 Page 6 of "MINOR LAND PARTITIONS" in Jackson County, Oregon.

Harry Chapman County Clerk — Thomas D. Jewett Deputy

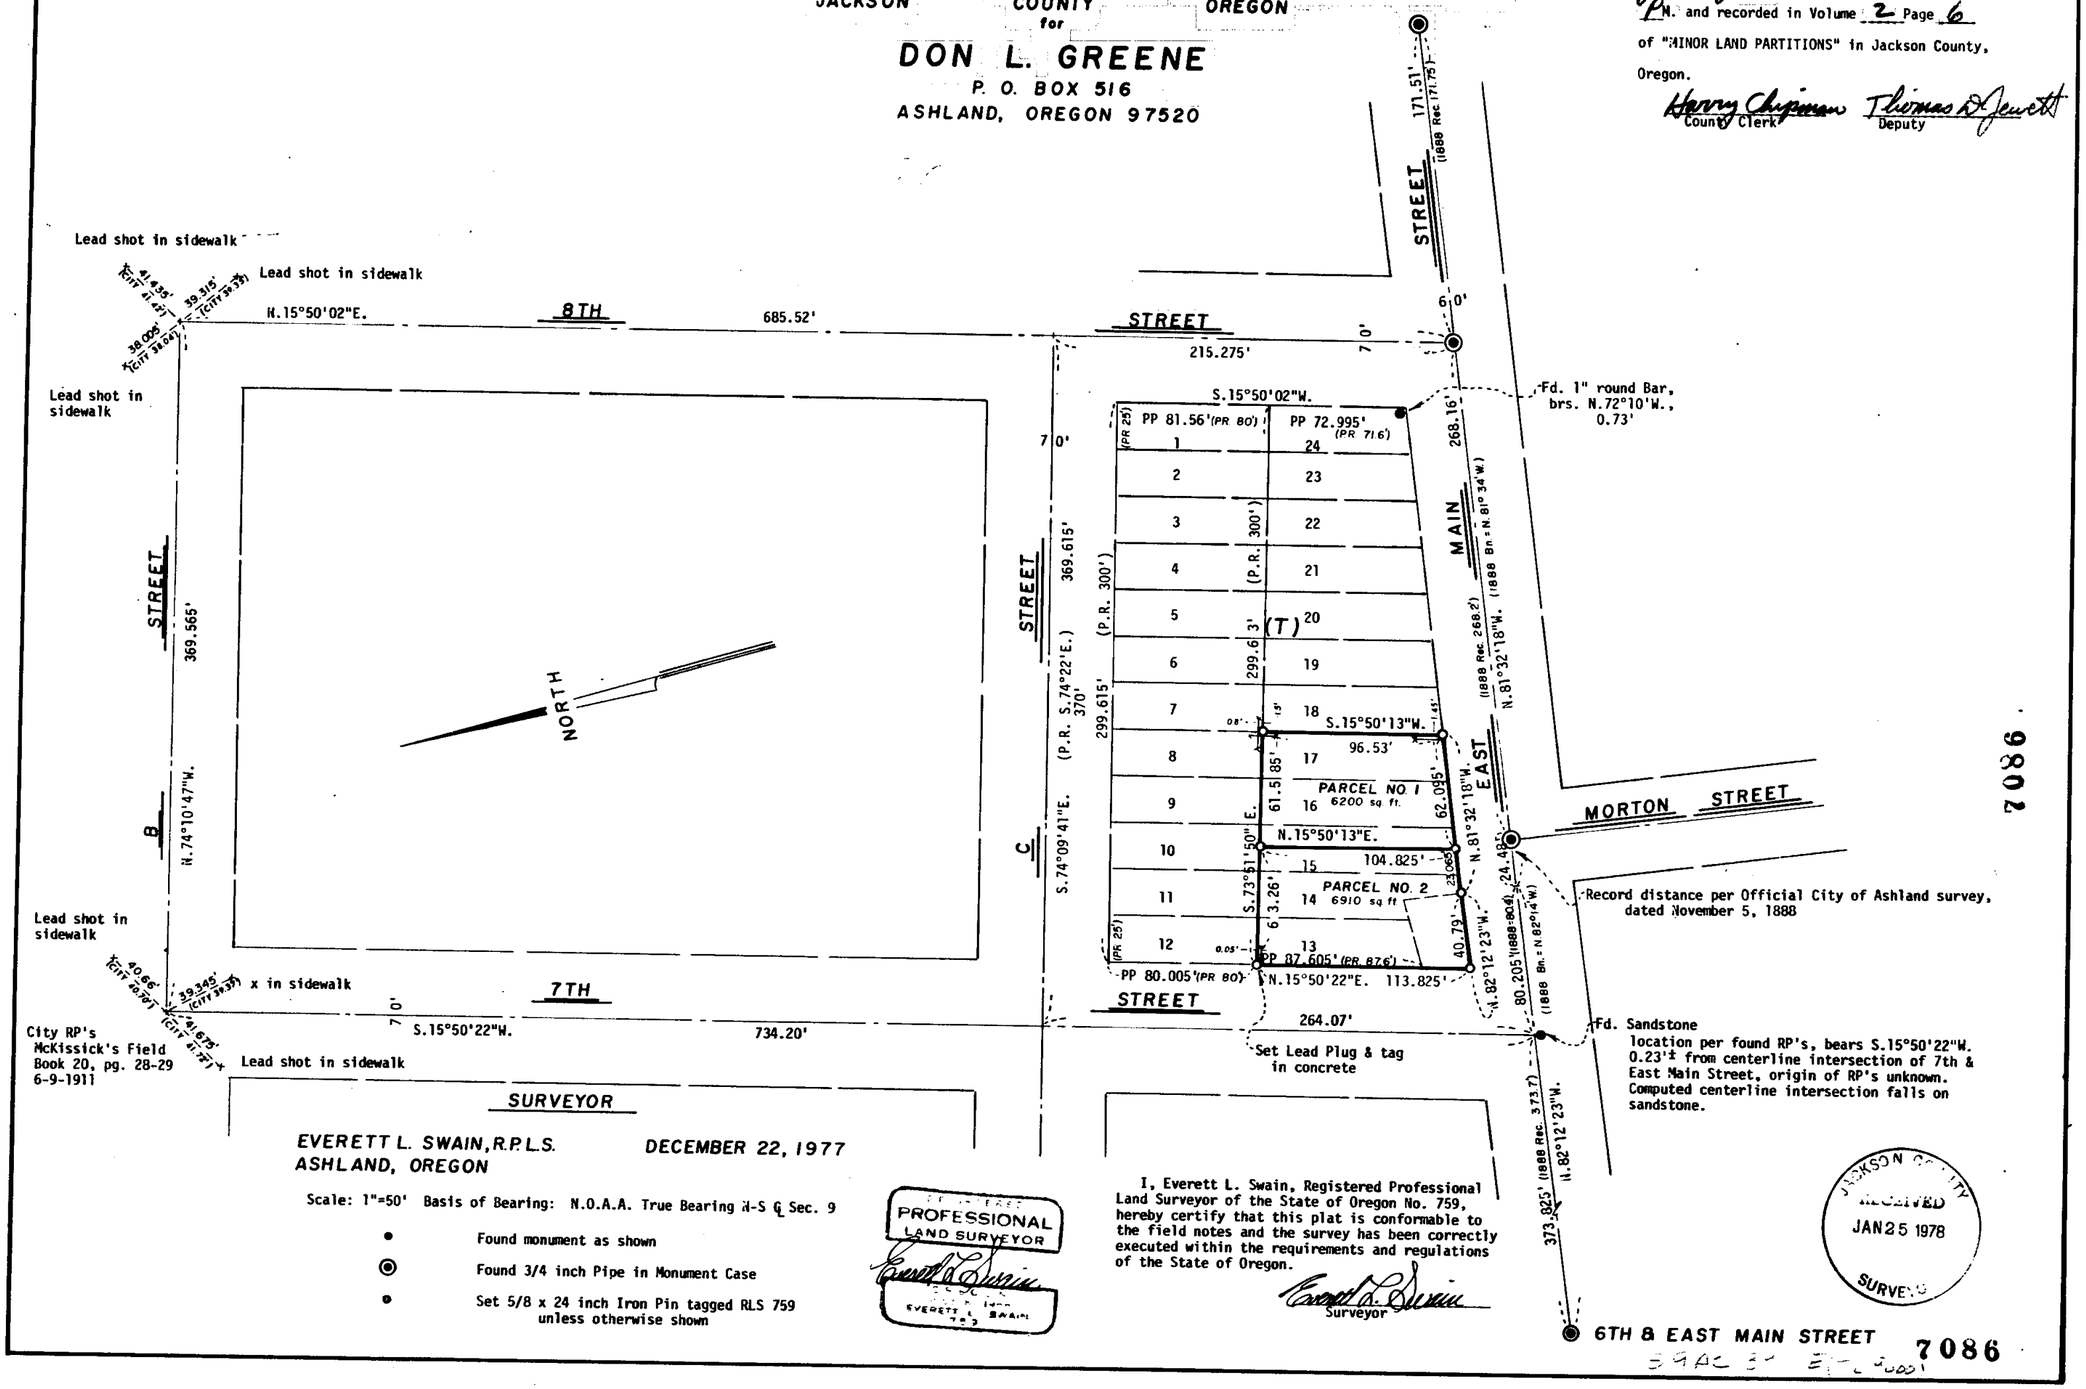

7086

SURVEYOR

EVERETT L. SWAIN, R.P.L.S. DECEMBER 22, 1977
ASHLAND, OREGON

Scale: 1"=50' Basis of Bearing: N.O.A.A. True Bearing W-S ℄ Sec. 9

- ● Found monument as shown
- ◉ Found 3/4 inch Pipe in Monument Case
- ● Set 5/8 x 24 inch Iron Pin tagged RLS 759 unless otherwise shown

OREGON PROFESSIONAL LAND SURVEYOR Everett L. Swain 759

I, Everett L. Swain, Registered Professional Land Surveyor of the State of Oregon No. 759, hereby certify that this plat is conformable to the field notes and the survey has been correctly executed within the requirements and regulations of the State of Oregon.

Everett L. Swain Surveyor

JACKSON COUNTY RECEIVED JAN 25 1978 SURVEYOR

7086

0 1 2 3 4 5 6

10 SCALE