

7120

SURVEY PLAT AND NARRATIVE TO COMPLY WITH
PARAGRAPH 209.250, OREGON REVISED STATUTES


Survey for: Clyde A. Norris
7322 Dark Hollow Road
Medford, Oregon 97501

Survey by: Charles H. Hurst
304 South Holly
Medford, Oregon 97501


Bearing: Based on Survey No. 2109

Purpose: Set monuments as shown per client's instructions.

Procedure: Held to lines previously monumented by Survey No. 6453.

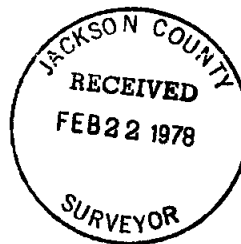

7120

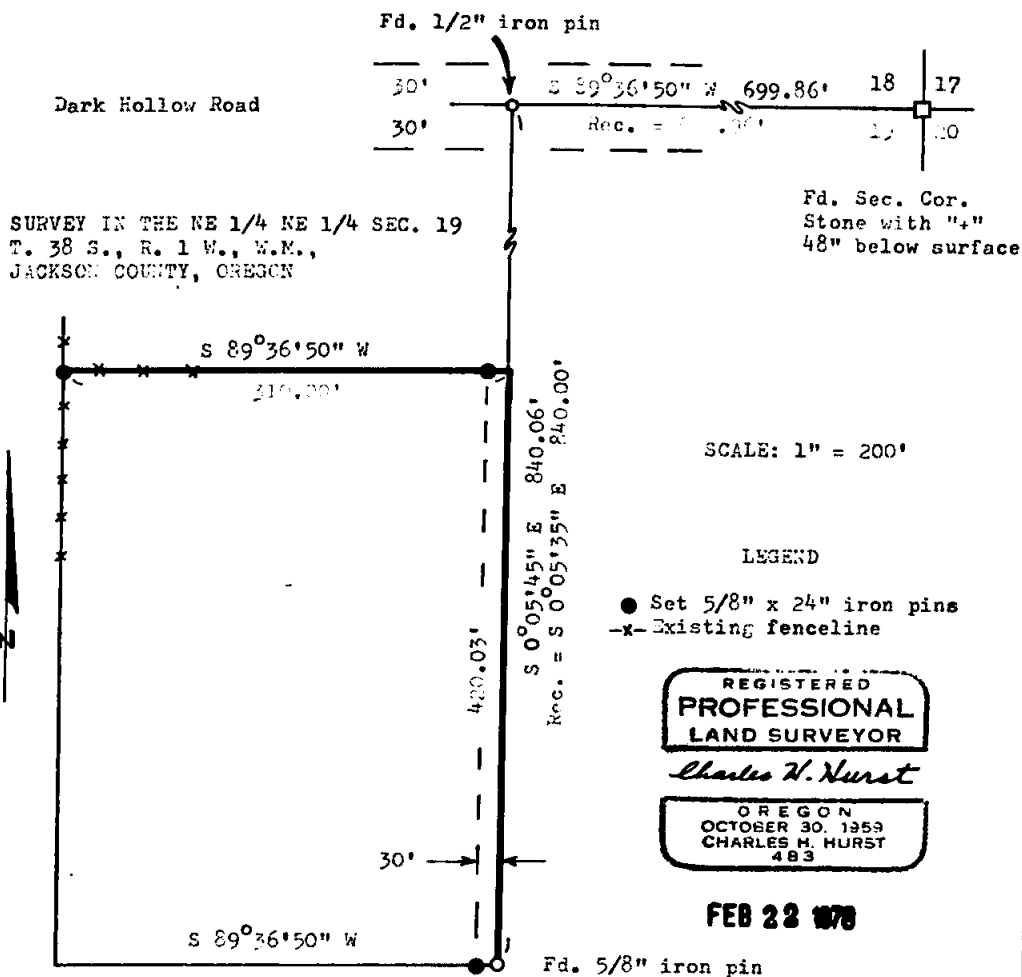

519 38 1W

7120

- 17.00 -