

7128

78-04571

BOWMONT SUBDIVISION


LOCATED IN
S.W. 1/4 OF SECTION 28, T.37S, R.1W., W.M.
IN THE CITY OF MEDFORD
JACKSON COUNTY, OREGON

I, J.A. HOFFBUHR DULY REGISTERED SURVEYOR OF
THE STATE OF OREGON, DO HEREBY CERTIFY THAT
THIS MAP REPRESENTS A SURVEY MADE BY ME OR
UNDER MY DIRECTION AND THE MONUMENTS CONFORM

REGISTERED
PROFESSIONAL
LAND SURVEYOR


J.A. Hoffbuhr

OREGON
NOV. 7, 1947
J. A. HOFFBUHR
222

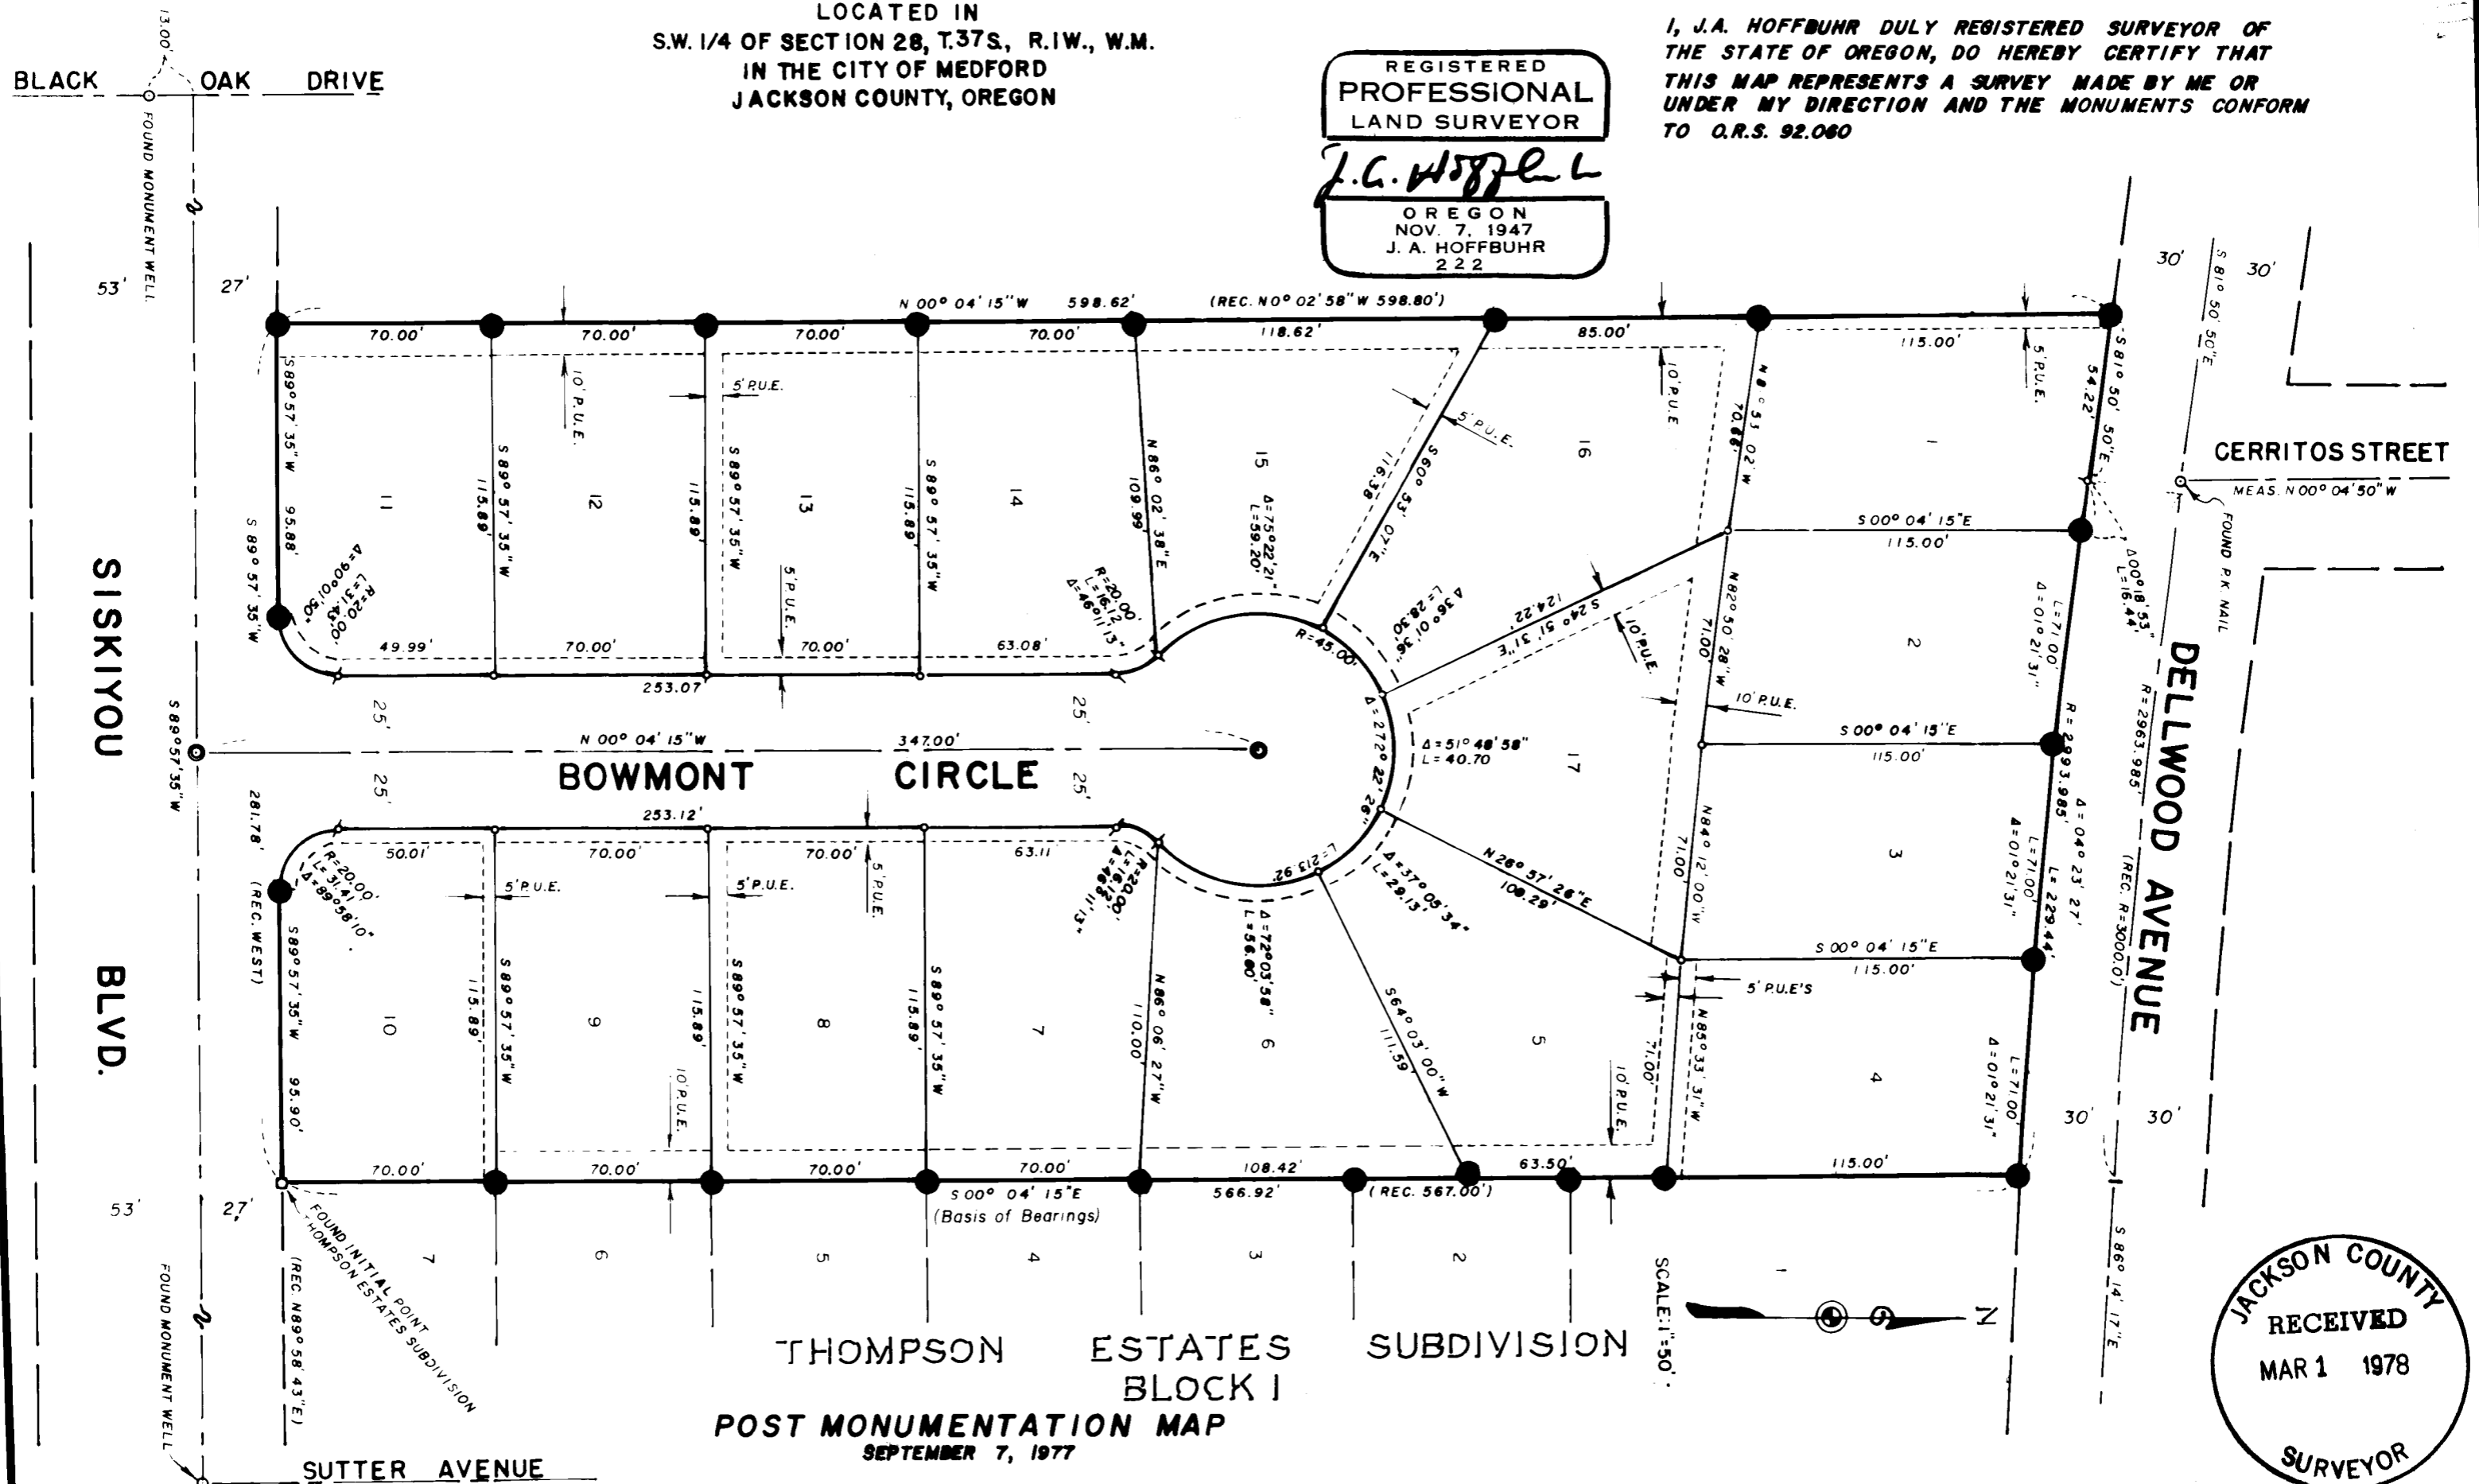

- = MONUMENTS FOUND PER ORIGINAL SUBDIVISION PLAT
- = SET 5/8" x 24" IRON PIN
- ⊕ = SET 5/8" x 30" IRON PIN
- ⊙ = SET BRASS DISC IN MONUMENT CASE

FILED FOR RECORD THIS 1 DAY OF
March 19 78 AT 2:02 O'CLOCK
P M. AND RECORDED IN THE OFFICIAL RECORDS
OF JACKSON COUNTY, OREGON.
Harry Chipman COUNTY CLERK *Betty Key* DEPUTY

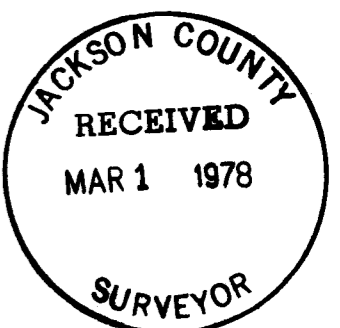

7128

AFFIDAVIT

I, J. A. Hoffbuhr, being duly registered as a Professional Land Surveyor in the State of Oregon, do hereby certify that the interior lot corners and necessary street monuments were placed in the proper locations as indicated on the respective subdivision plats and as required by O.R.S. 92.060 in the following subdivisions, as required for post-monumentation, during the period immediately prior to the date shown below:

- 4/7 Bowmont Subdivision - City of Medford 3-27-76
- 6/1 Greenbrook Subdivision - City of Medford 5-29-76
- 5/184 Hilton Heights Subdivision - City of Medford 5-24-75
- 5/194 Greenbrae Subdivision, Unit #1 - City of Medford 10-25-75
- 6/17 Greenbrae Subdivision, Unit #2 - City of Medford 1-8-77

I HEREBY CERTIFY that the above statement is accurate and provides the necessary proof of monumentation to satisfy all statutory requirements.

J. A. Hoffbuhr
J. A. Hoffbuhr


State of Oregon)
) ss.
County of Jackson)

February 20, 1978

Personally appeared the above named J. A. Hoffbuhr and acknowledged the foregoing to be his voluntary act and deed.

Before Me:

Carson Jackson
Notary Public for Oregon
My commission expires 10-20-79

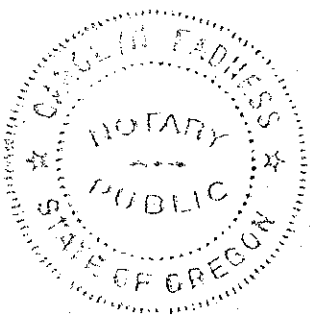

Jackson County, Oregon
Recorded
OFFICIAL RECORDS

2:02 MAR 1 1978 P.M.

HARRY CHIPMAN
CLERK and RECORDER

By *Billy King* Deputy

