


7151

SURVEY FOR HARRY WHITESIDES
LOTS 5 & 6, BLOCK 10, DEKUM'S AMENDED ADDITION
GOLD HILL, OREGON
SECTION 16, T. 36 S., R. 3 W., W.M.

April, 1977

7151

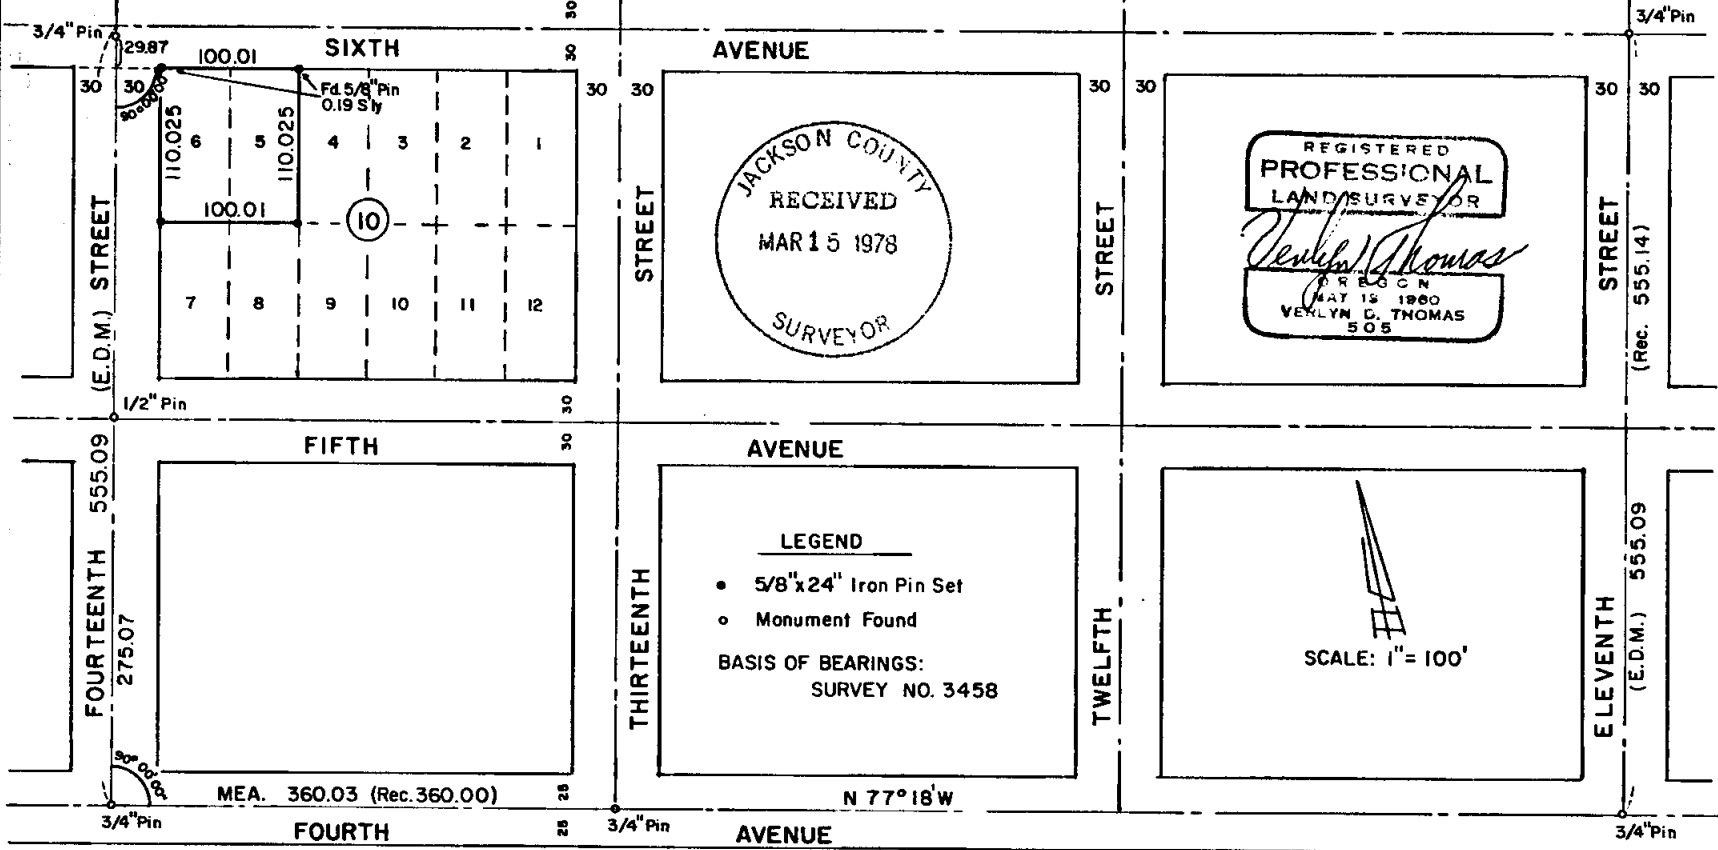

REGISTERED
PROFESSIONAL
LAND SURVEYOR

Verlyn Thomas

OREGON
MAY 15 1960
VERLYN D. THOMAS
505

JACKSON COUNTY
RECEIVED
MAR 15 1978
SURVEYOR

LEGEND

- 5/8" x 24" Iron Pin Set
- Monument Found

BASIS OF BEARINGS:
SURVEY NO. 3458

SCALE: 1" = 100'

SURVEY NARRATIVE TO COMPLY WITH O.R.S. 209.250
REVISED BY CHAPTER 655, O.L. 1963

FOR: Harry Whitesides
233 Belmont Avenue
Long Beach, California 90803

PURPOSE: To survey and monument Lots 5 and 6, Block 10, DEKUM'S AMENDED ADDITION in Gold Hill.

PROCEDURE: Recovered monuments established by Recorded Survey No. 3458 at 11th Street and Sixth Avenue, 11th Street and Fourth Avenue, 13th Street and Fourth Avenue, 14th Street and Fourth Avenue. Reestablished the pattern of retracement from said Survey No. 3458, holding 90° angles from these monuments. This procedure missed the 5/4" iron pin at Sixth Avenue and 14th Street by 0.13, as shown on the accompanying plat.

Monumented lots on this basis, measuring all courses between street monuments with electronic distance measuring equipment.

