

7156

SURVEY FOR LARRY PICKELL


LOT 18, BLOCK I, WALNUT PARK ADDITION
CITY OF MEDFORD
JACKSON COUNTY, OREGON

May 6, 1977

71561




10 SCALE

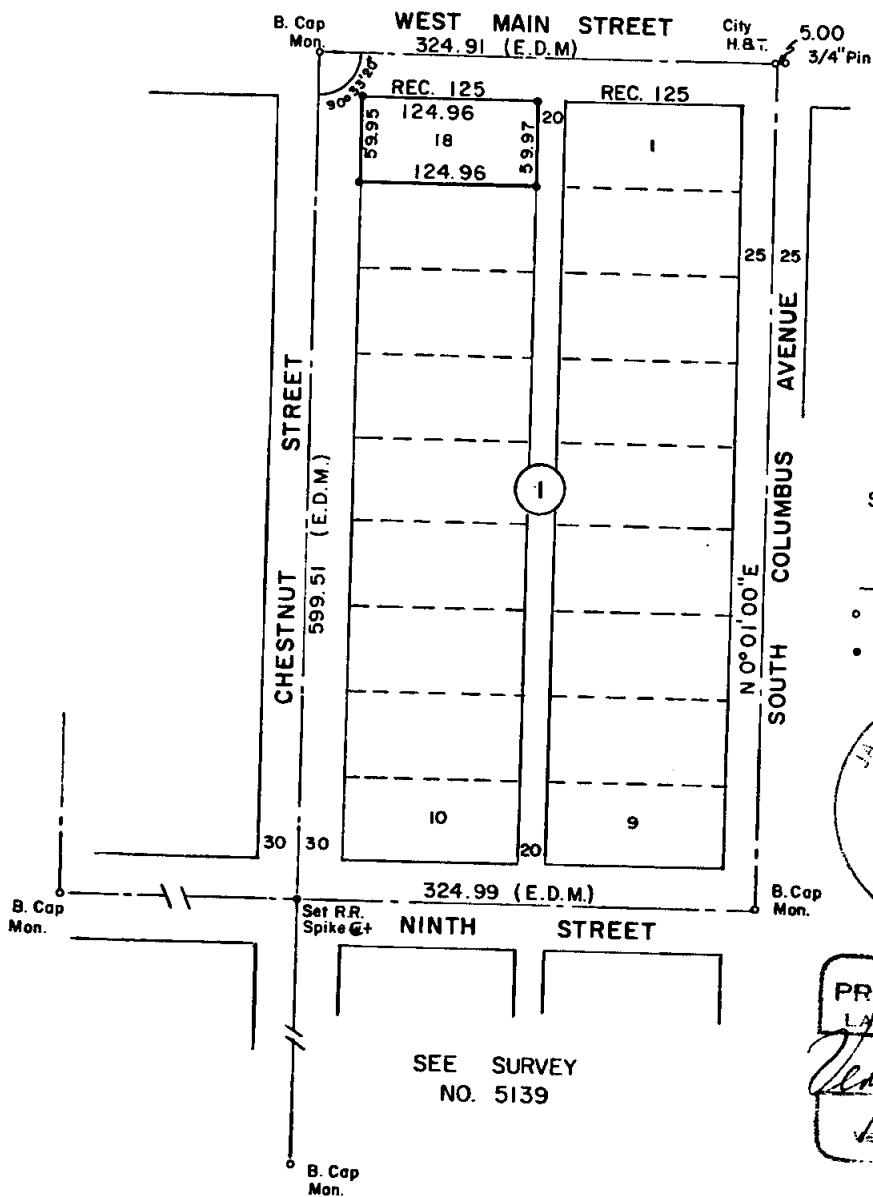

SCALE: 1" = 100'

LEGEND

- Monument Found
- 5/8"x24" Iron Pin Set unless otherwise noted

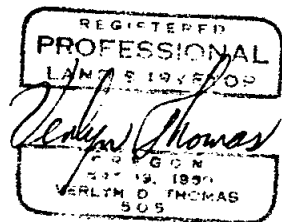

SEE SURVEY NO. 5139

505 CB 37 2W

SURVEY NARRATIVE TO COMPLY WITH O.R.S. 209.250
REVISED BY CHAPTER 555, O.L. 1963

FOR: Larry Pickell, Builder
Chestnut Street at West Main
Medford, Oregon

PURPOSE: To survey and monument Lot 18, Block 1, WALNUT PARK ADDITION, Med-
ford, Oregon.

PROCEDURE: Recovered street centers of record and measured around Block. Es-
tablished pro-rated location of lot from said measurements.

