


SURVEY NO. 6697, 8812

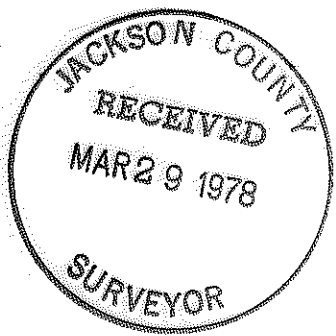

PLAT OF SURVEY
FOR

BENJAMIN H. BELKNAP
 BEING A PORTION OF D.L.C. NO. 76, IN
 THE NORTHWEST ONE-QUARTER OF SEC.
 26, T.37S., R.2W., W.M
 JACKSON CO. SCALE 1"=100'
 OREGON DATE: MARCH, 1978
 PREPARED BY: FRIAR-MOFFIT SURVEYING

LEGEND:

- = FOUND MONUMENT AS SHOWN.
- = SET 5/8" PIN WITH PLASTIC CAP STAMPED, MOFFIT, 944

BASIS OF BEARINGS:
SURVEY NO. 6697

REGISTERED
PROFESSIONAL
LAND SURVEYOR

Lloyd R. Moffit

OREGON
JULY 17, 1970
LOYD R. MOFFIT
944

7/88

526 B 37 2 W (T.L. 1000) 7188

SURVEY NO. 7188

SURVEY NARRATIVE TO COMPLY WITH O.R.S. 209.250

SURVEY FOR: BENJAMIN H. BELKNAP
67 PERRYDALE AVENUE
MEDFORD, OREGON 97501

LOCATION: A PORTION OF DONATION LAND CLAIM NO.
76, ALSO A PORTION OF THE NORTHWEST
ONE-QUARTER (1/4) OF SECTION 26,
TOWNSHIP 37 SOUTH, RANGE 2 WEST,
WILLAMETTE MERIDIAN, JACKSON COUNTY,
OREGON.

PURPOSE: TO SURVEY AND MONUMENT THAT CERTAIN
PARCEL OF LAND DESCRIBED IN INSTRUMENT
NUMBER 77-14370, JACKSON COUNTY OFFICIAL
RECORDS.

PROCEDURE: USING MONUMENTS EITHER FOUND OR SET
DURING SURVEYS 3479 AND 6697, AND MY
TRAVERSE WHICH TIES SAID POINTS TO-
GETHER, I SET THE MONUMENTS AS SHOWN
ON THE ATTACHED MAP.

THE FENCES IN THE AREA OF THIS SURVEY
ARE INCONSISTENT WITH PROPERTY LINES
DETERMINED BY DEED DESCRIPTIONS. THE
INCONSISTENCIES ARE SHOWN ON SURVEY NO.
6697 AND THE ATTACHED MAP.

DATE: MARCH, 1978
FRIAR-MOFFIT SURVEYING CO.

