


7217


7217

SURVEY FOR: WHITE CITY CORPORATION  
LOCATED IN THE EAST-HALF OF SEC. 19, T.36S., R.1W., W.M.  
BY: MARK E. BOYDEN  
APRIL 20, 1978

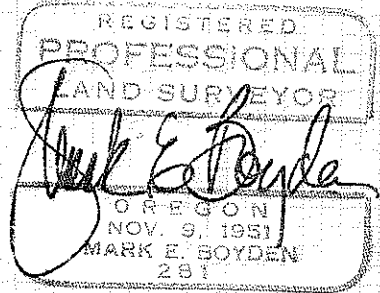

Old 8th St. — ANTELOPE ROAD

N89°48'W 221.70'

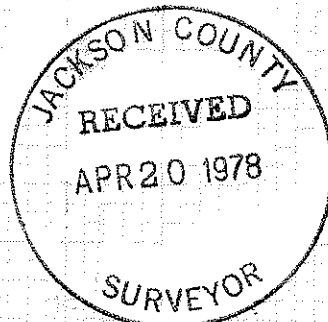

3.00 Ac. ±

RECORDED SURVEY NO. 5509  
(INST. NO. 74-03455)

589.48'

589.47'

S0°11'50"W

N0°11'50"E

EXISTING POWER LINE  
40' INGRESS-EGRESS AND UTILITIES EASEMENT RESERVED BY WHITE CITY CORPORATION

221.70' AVENUE  
N89°48'10"W  
1446.46' "A"  
19  
20  
1/4 Corner

AGATE ROAD

SCALE: 1"=100'

- Found 3/4" iron pin flush
- Set 3/4" X 24" re-bar flush
- ⊙ Found bronze disk set in concrete

BASIS OF BEARINGS: RECORDED SURVEY NO. 5509

7217  
S19(112) 36 1W

Survey No. 7217

SURVEY NARRATIVE TO COMPLY WITH O.R.S. 209.250

FOR: White City Corporation  
White City, Oregon

PURPOSE: To monument and describe a tract within the White City Corporation ownership proposed to be conveyed, being located in the East-half of Section 19, Township 36 South, Range 1 West of the Willamette Meridian.

PROCEDURE: From old Army Engineer's bronze disk street controls and monuments found set on Recorded Survey No. 5509, monumented the additional tract corners at positions shown on the annexed map.

April 20, 1978

