



SURVEY NARRATIVE TO COMPLY WITH O.R.S. 209.250

FOR: Boise Cascade Corporation
Attn: Bob Morris
P. C. Box 100
Medford, Oregon 97501

PURPOSE: To monument and describe two tracts within the Boise Cascade ownership proposed to be conveyed, being located in the Southeast quarter of Section 10 and the Southwest quarter of Section 11, Township 37 South, Range 2 West, W.M.

PROCEDURE: From controls previously utilized on Recorded Survey Nos. 1901 and 3652 and the re-referencing of the Northeast corner of Donation Land Claim No. 64 by the County Surveyor on March 21, 1974, monumented the desired tracts at positions shown on the annexed map. From the re-set 1" galvanized iron pipe set 12" below the creek bed, set a 3/4" x 30" rebar witness corner Easterly 7.00 feet and Easterly 20.00 feet from said 1" galvanized iron pipe corner.

May 22, 1978

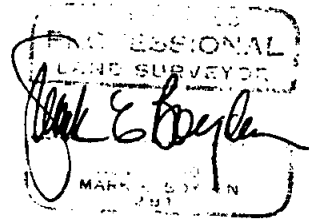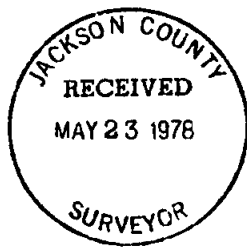

10 SCALE