

7296

7296

N.W. CORNER SECTION 10

SURVEY NO. 4982

N. 1/4 CORNER SECTION 10

FD. 2" IRON PIPE

N. 89°46'19"E.  
1328.985'

2657.97' (2657.80')

1328.985'

FD. 1" PIPE



1328.34'

N. 00°07'15"W.

1327.90'

N. 89°43'48"E.

2654.75'

1327.37'

12'

19'

2655.79'

N. 00°04'25"W.

1326.405' (2652.86')

2652.81'

S. 00°01'35"E.

1328.34'

SURVEY NO. 6102

1326.805'

S. 89°41'17"W.

2653.61'

1326.805'

(2653.70)


FD. 1" I. PIPE  
WITNESS CORNER  
S. 00°05'50"W. 5.00'

C. 1/4 SECTION 10  
FD. 1" I. PIPE

SURVEY NO. 5431

LEGEND:

- = FOUND MONUMENT AS SHOWN
- = SET 5/8" IRON PIN WITH PLASTIC CAP STAMPED, FRIAR 961

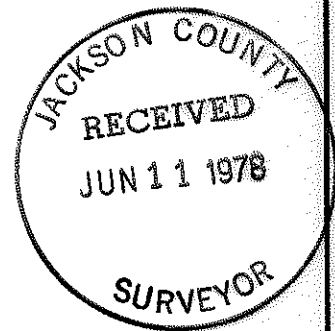

PLAT OF SURVEY

FOR

MAX LYND

BASIS OF BEARINGS:

SURVEY NO. 5752

REGISTERED PROFESSIONAL LAND SURVEYOR

*Larry J. Friar*  
OREGON  
JUL 16, 1971  
LARRY J. FRIAR  
961

LOCATED IN THE N. W. 1/4 OF SECTION 10,  
TOWNSHIP 35 SOUTH, RANGE 4 WEST WM.  
JACKSON COUNTY OREGON

SCALE: 1" = 400' DATE: APRIL 1978

PREPARED BY: FRIAR-MOFFIT SURVEYING  
MEDFORD, OREGON

S10 35 4W

7296

SURVEY NO. 7296

SURVEY NARRATIVE TO COMPLY WITH O.R.S. 209.250

SURVEY FOR: MAX LYND  
977 PLEASANT CREEK ROAD  
WIMER, OREGON

LOCATION: NORTHWEST ONE-QUARTER (1/4) SECTION  
10, TOWNSHIP 35 SOUTH, RANGE 4 WEST,  
WILLAMETTE MERIDIAN, JACKSON COUNTY,  
OREGON.

PURPOSE: TO SET THE SOUTHWEST AND THE SOUTH-  
EAST CORNERS AND RUN THE SOUTH LINE  
OF THE NORTHWEST ONE-QUARTER (1/4)  
OF THE NORTHWEST ONE-QUARTER (1/4)  
OF SECTION 10, TOWNSHIP 35 SOUTH,  
RANGE 4 WEST, WILLAMETTE MERIDIAN.

PROCEDURE: SET CORNERS FROM TIES COMPUTED  
FROM CONTROL TRAVERSE MADE DURING  
THE EXECUTION OF SURVEY NUMBER 6102  
BY THIS OFFICE.

DATE: MAY 24, 1978

FRIAR-MOFFIT SURVEYING CO.

