

78-14756

SUN OAKS, PHASE I
A SUBDIVISION
IN THE CITY OF MEDFORD


LOCATED IN THE N.E. 1/4 OF SECTION 32
AND THE NW 1/4 OF SECTION 33, D.L.C.
NO. 51, T.37S., R.1W., W.M., JACKSON COUNTY,
OREGON

POST MONUMENTATION MAP
JUNE 30, 1978

- MONUMENTS PER ORIGINAL SUBDIVISION PLAT
- SET 3/4" X 24" RE-BAR
- ▲ SET MONUMENT AS INDICATED

NOTE: SEE PLAT OF SUN OAKS, PHASE I, FILED
FOR RECORD THE 30TH DAY OF JUNE, 1977 AT
10:49 O'CLOCK A.M. AND RECORDED IN VOLUME 13
OF PLATS AT PAGE II OF RECORDS OF JACKSON
COUNTY, OREGON FOR LOT BEARINGS AND
DISTANCES.

I, MARK E. BOYDEN, DULY REGISTERED SURVEYOR
OF THE STATE OF OREGON, DO HEREBY CERTIFY
THAT THIS MAP REPRESENTS A SURVEY MADE
BY ME OR UNDER MY DIRECTION AND THE MON-
UMENTS CONFORM TO O.R.S. 92.060.

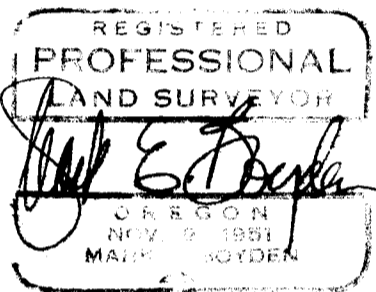

78-14756

EXAMINED AND APPROVED THIS 30th DAY
OF June, 1978.

William Beck
CITY SURVEYOR

FILED FOR RECORD THIS 30th DAY OF
June 1978 AT 4:13
O'CLOCK P.M. AND RECORDED IN THE
OFFICIAL RECORDS OF JACKSON COUNTY,
OREGON.

Harry Chipman COUNTY CLERK
Thomas D Jewett DEPUTY

