

MAP OF SURVEY  
 LOCATED IN  
 S.E. 1/4 of Sec. 33, and S.W. 1/4 of Sec. 34, T37S, R2W, W.M.  
 JACKSON COUNTY, OREGON  
 FOR

**MARY BROWN**

HOFFBUHR SURVEYING, INC. MEDFORD, OREGON  
 SCALE: 1" = 200' AUGUST 23, 1978  
 BASIS OF BEARING R/S NO. 5179  
 O = SET 5/8" x 24" IRON PIN

REGISTERED  
**PROFESSIONAL**  
**LAND SURVEYOR**

*Richard L. Bath*

OREGON  
 JULY 30, 1976  
 RICHARD L. BATH  
 No. 1069

37 2W 33 (T.L. 700)

8692

SURVEY NO. 7398

SURVEY NARRATIVE TO COMPLY WITH PARAGRAPH 209.250  
OREGON REVISED STATUTES

SURVEY FOR: Mary Brown  
3915 Bellinger Lane  
Medford, Oregon 97501

LOCATION: Southeast one-quarter (1/4) of Section 33 and  
Southwest one-quarter (1/4) of Section 34,  
Township 37 South, Range 2 West, Willamette  
Meridian, Jackson County, Oregon

PURPOSE: To survey, monument and describe the parcel as  
shown on attached map per client's request

PROCEDURE: Using information acquired by this office for  
Recorded Survey No. 5179, located necessary monuments, fence lines,  
and existing county road centerlines to accomplish this survey.


Review of the file for Recorded Survey No. 5179 produced the  
unrecorded survey map prepared by L. E. Ager (deceased). With the  
field data shown on the unrecorded map, discrepancies noted per  
Recorded Survey No. 5179, and upon consultation with our client,  
the decision was made to hold the existing fence lines as shown  
since they fell within our client's title lines. A boundary line  
agreement was prepared along an existing fence line as shown.

Witness corners were set at right of way lines since no attempt  
was made to reconstruct the actual centerlines of the county roads.  
Basis of bearing--Recorded Survey No. 5179

August 29, 1978

REGISTERED  
PROFESSIONAL  
LAND SURVEYOR  
*Richard L. Bath*  
OREGON  
JULY 30, 1976  
RICHARD L. BATH  
No. 1069

Richard L. Bath  
Hoffbuhr Surveying, Inc.

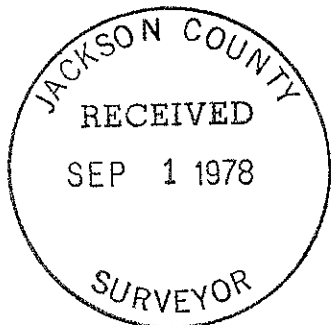

7398