



MAP OF SURVEY

LOCATED IN SECTION 21 S.W. 1/4
T 34 S, R 2 E, W.M., JACKSON
COUNTY, OREGON

FOR
KEN JONES


BASIS OF BEARING: 1856 GLO PLAT RECORD OF THE
SECTION LINE FROM THE SECTION
CORNER COMMON TO SECTIONS
20, 21, 29, & 28 AND THE
1/4 CORNER OF 20 & 21.

- FD. BLM BRASS CAP
 - SET 2" x 30" G.I.P. W/ 2 1/2" BRASS CAP
- SCALE: 1" = 300'
DATE: AUGUST 18, 1978

REGISTERED
PROFESSIONAL
LAND SURVEYOR

Kurt C. Weaver

OREGON
JULY 14, 1978
KURT C. WEAVER
1679

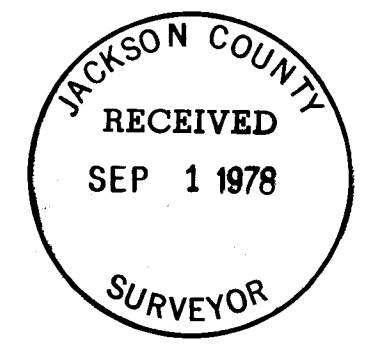

34 2E S21 (TL. 4900)

N 1/4 Section 21:

A D. Fir 6" dia. bears N 76°38' W 15.4 ft.
A D. Fir 9" dia. bears S 27°09' W 10.4 ft.

S 1/4 Section 21:

A D. Pine 6" dia. bears N 15°39' W 20.1 ft.
A D. Fir 9" dia. bears S 70°23' E 27.7 ft.

C 1/4 Section 21:

A D. Fir 11" dia. bears N 37°54' W 18.6 ft.
A B. Oak 6" dia. bears S 66°14' W 18.0 ft.

W 1/16 Sections 21/28:

A D. Fir 8" dia. bears W 82°44' W 25.9 ft.
A D. Fir 8" dia. bears S 1°17' W 18.9 ft.

SW 1/16 Section 21:



A D. Fir 11" dia. bears S 8°52' W 55.5 ft.
An I. Cedar 10" dia. bears W 65°25' W 22.1 ft.

S 1/16 Sections 20/21:

A D. Fir 11" dia. bears S 30°31' W 22.7 ft.
A D. Fir 7" dia. bears S 44°27' E 14.8 ft.

Surveyed By: T. Flatebo & Associates
P.O. Box 900
Jacksonville, Oregon

Date: August 18, 1978

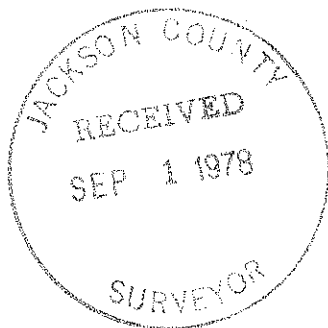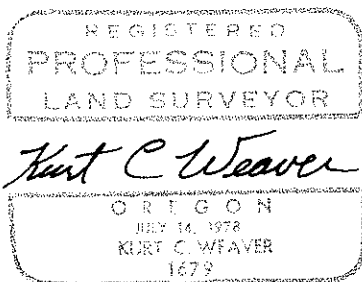

7401

Survey No. 7401

SURVEY NARRATIVE TO COMPLY WITH O.R.S. 209.250

Survey For: Mr. Ken Jones
235 Terrace
Ashland, Oregon

Location: Located in the Sw $\frac{1}{4}$ of Section 21, T34S,
R2E, W.M., Jackson County, Oregon.

Purpose: To monument and mark the boundary of the
NW $\frac{1}{4}$, NE $\frac{1}{4}$ and the SE $\frac{1}{4}$ of the SW $\frac{1}{4}$ of Section 21.

Procedure: A closed traverse was conducted, which
incorporated all of the existing controlling
corners. The North and South $\frac{1}{4}$ corners are lost
and were positioned via straight line proportion.

The lost $\frac{1}{4}$ corners were searched for extensively
by me. The Jackson County Surveyors field crew
visited both corner vicinities on two separate
occasions and could find no evidence of the
original positions.


In the vicinity of the South $\frac{1}{4}$ corner a BLM "K"
tag, posted on a tree indicates the position
of the corner. However, this position could
not be verified. There are two dead and down
trees which correspond to the description of
the original BT's at this location, however
neither of the trees contain scribing.

This position falls N 72°17'55" W 106.72 feet
from the proportionate position. The original
notes for the section line common to sections
21 and 28 contain one topographic call. This
being a ridge call to the East at 21.00 chains
West of the SE section corner or 18.80 chains
East of the $\frac{1}{4}$ corner. This call is located at
24.0 chains from section corner and 17.3 chains
from the "K" tag location. It became apparent
that this call could not be used to verify a
position. After expending some 20 man-hours in
search of evidence related to this $\frac{1}{4}$ corner the
corner was determined lost and was proportioned.

The North $\frac{1}{4}$ corner presented a similiar circum-
stance. This corner had apparently been searched
for by several people. Many trees had been
chopped into and most dead and down trees had
been thoroughly cut up. An extensive search for
evidence was made of an area several chains
around the proportionate position. The propor-
tionate position falls near the intersection of
a N-S and an E-W brushed lines.

After the proportionate corners were positioned
the section was subdivided. Sixteenth corners
were set as shown and the boundary was brushed
and marked.

The following Bearing Trees were taken at the
set corners:

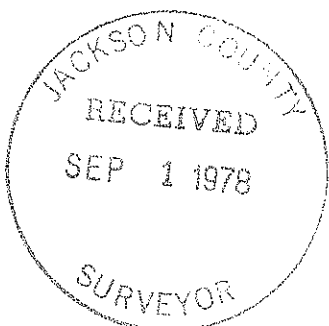

7401