

7434

OREGON STATE HIGHWAY DIVISION

743

Located Line

# HEAD ROAD - AIRPORT ROAD SE

## BIDDLE ROAD (CO. RD.)

### JACKSON COUNTY


Scale: 1 inch = 100 feet

7434

Traced by A.L.B.

January, 1975

Revised: May, 1976; Mar., 1977

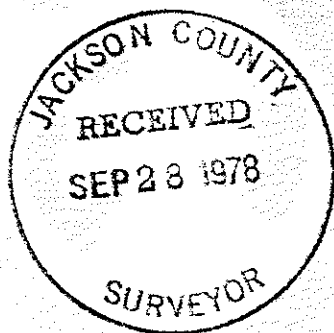

GRID BEARINGS - SOUTH ZONE

DRG. NO. 9B-11-8

Note: Coordinates used on this map are on a Local Datum Plane which represents true ground distances. Bearings are Oregon State Grid South Zone. To convert LDP Coordinates to Oregon State Grid South Zone, multiply LDP Coordinates by 0.9999263.

*'Set Pin' Indicates Set 5/8" x 30" Capped Iron Pin.*

REGISTERED  
PROFESSIONAL  
LAND SURVEYOR

*Alfred Shirley Jr.*

OREGON  
EST. JUL. 1977  
ALFRED SHIRLEY, JR.  
1023