SURVEY PLAT & NARRATIVE TO COMPLY WITH PARAGRAPH 208.250
OREGON REVISED STATUTES

SURVEY FOR: Lewis J. Cooper
134 Fawn Way
Eagle Point, Ore. 97524

BEARINGS : Survey No. 1795 (derived from Agate Subdivision)

PROCEDURE : R/W for Kershaw Road produced Southerly on basis of existing monumentation.

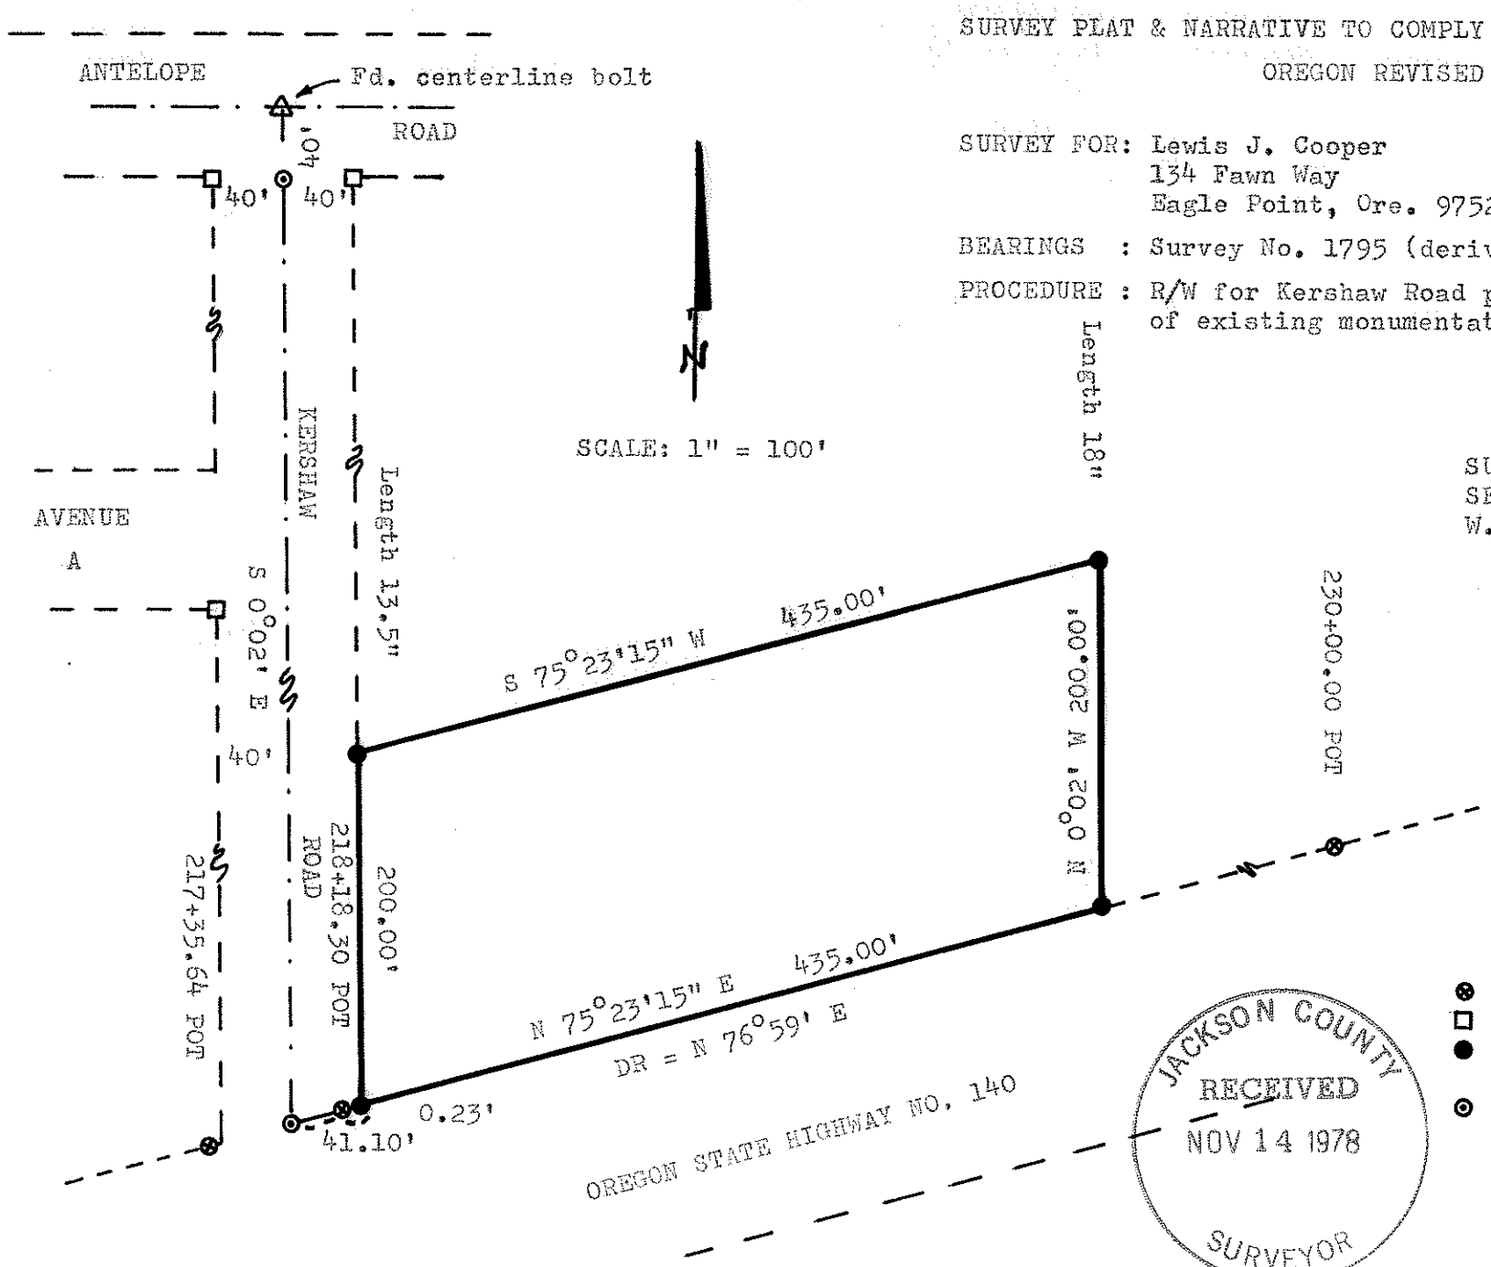

SURVEY SITUATE IN THE NW¼ SE¼
SECTION 22, T. 36 S., R. 1 W.
W.M., JACKSON COUNTY, OREGON.

REGISTERED
PROFESSIONAL
LAND SURVEYOR
Charles H. Hurst
OREGON
OCTOBER 30, 1959
CHARLES H. HURST
483

OCT 2 1978

LEGEND
- ⊗ Fd. "Sv. Cap" R/W Monuments
- □ Fd. Concrete R/W Monuments
- ● Set 5/8" x 24" iron pins unless otherwise indicated
- ⊙ Set railroad spikes

SURVEY BY:

Charles H. Hurst
304 South Holly
Medford, Ore. 97501

JACKSON COUNTY
RECEIVED
NOV 14 1978
SURVEYOR

S22 36 1W (T.L. 4003) #479