


PRELIMINARY ADMINISTRATIVE SURVEY  
 FOR FOREST MANAGEMENT PURPOSES OF THE  
 MEDFORD DISTRICT  
 BUREAU OF LAND MANAGEMENT  
 T.34S., R.4W., SEC. 5, W.M.  
 JACKSON COUNTY  
 SURVEYED BY: T. Nickerson DATE: Sept. 26, 1978

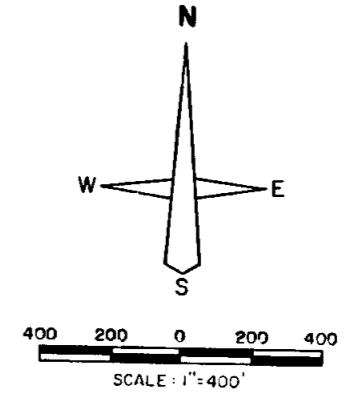


Bearings of reference trees are to the head of a spike driven into the bottom of a blaze near the base of the tree.  
 Distances are to side-center of the tree.  
 Lines between U.S. and Pvt. were blazed and yellow metal boundary tags were posted.  
 Bearings are based on Solar Observation.



REGISTERED PROFESSIONAL LAND SURVEYOR  
*James O. Nickerson*  
 OREGON  
 TERRANCE J. NICKERSON  
 1-49

- Original corner found.
- Monument found.
- Monument set, (5/8"x24" rebar).
- Line surveyed.
- True line blazed and posted.

- Ref. No. 1 U.S. Gov't. survey by Rollin D. Aanrud, approved 1965.
- Ref. No. 2 U.S. Gov't. survey by James E. Jelley, approved 1962.
- Ref. No. 3 U.S. Gov't. survey by C. Albert White, approved 1958.
- Ref. No. 4 Survey by Marvin Ramsey, Survey No. 2483, Jackson County, Oregon.

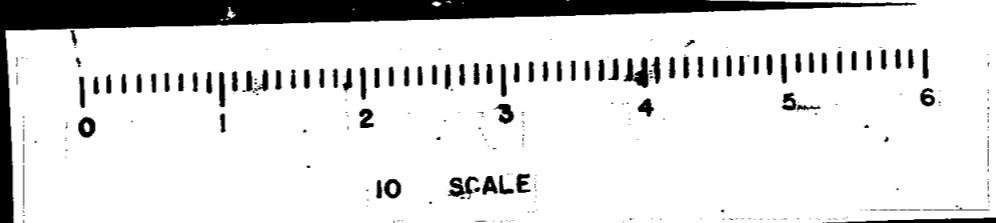

S5 (T. 100) 3-S ~

7488

11-1

## CHAINS

A Douglas-fir, 18 ins. diam., (Record, 24 ins.), bears N. 44° W., 44.2 ft. dist., with healed blaze.

Cor. of secs. 5, 6, 31, and 32, Tps. 33 and 34 S., R. 4 W. Monumented with an iron post, 2½ ins. diam., firmly set, protruding 6 ins. above the ground, with brass cap mkd.

T33S R4W	
S 31	S 32
S 6	S 5
T34S	
1962	

from which the remains of the original bearing trees

A fir stump, size indeterminate, with fallen log alongside, bears N. 31° E., 21.8 ft. dist., with no visible blaze on stump and scribe marks 33S R4W S3 visible on fallen log.

A fir stump, 14 ins. diam., bears S. 42° W., 54.8 ft. dist., with scribe marks BT visible on partially healed blaze.

A sawed fir stump, 36 ins. diam., bears N. 77° W., 27.7 ft. dist., with no visible blaze.

and from which bearing trees mkd. by James Jelley in 1962

A fir snag, 10 ins. diam., bears N. 27° E., 24.4 ft. dist., with healed blaze.

A fir, 18 ins. diam., bears S. 19° E., 51.5 ft. dist., with healed blaze.

A fir, 8 ins. diam., bears S. 56° W., 40.9 ft. dist., with healed blaze.

A cedar, 17 ins. diam., bears N. 20° W., 47.5 ft. dist., with healed blaze.

An iron post, 3 ins. diam., firmly set, protruding 24 ins. above the ground, bears S. 43° E., 1.0 ft. dist., with brass cap mkd. US GEOLOGICAL SURVEY, ELEVATION ABOVE SEA LEVEL 2439.3 FEET, DATUM G BM.

¼ cor. secs. 5 and 32, Tps. 33 and 34 S., R. 4 W. Reestablished by Marvin Ramsey, O.R.L.S. 404, in 1962, monumented with an iron pipe, 1 in. diam., firmly set, protruding 6 ins. above the ground, with no marks visible,

from which

A fir, 10 ins. diam., bears N. 30° W., 36.3 ft. dist., with scribe marks ½ S5 visible on opened blaze.

CHAINS

Cor. of secs. 4, 5, 32, and 33 - Tps. 33 and 34 S.,  
R. 4 W. Monumented with an iron post, 2½ ins. diam.,  
firmly set, protruding 4 ins. above the ground, in a  
collar of stone, 2½ ft. base, to top, with brass cap mkd.

T33S R4W  
S 32 | S 33  
S 5 | S 4  
T34S  
1965

from which the remains of the original bearing trees

A Douglas-fir, 33 ins. diam., bears N. 35° E.,  
19.8 ft. dist., with healed blaze.

A Douglas-fir, 36 ins. diam., bears S. 43° E.,  
18.5 ft. dist., with open and burned blaze.

A Douglas-fir, 32 ins. diam., bears S. 11° W.,  
11.9 ft. dist., with healed blaze.

A burned Douglas-fir stump, size indeterminate,  
bears N. 48° W., 35.6 ft. dist., no visible  
blaze.

and a bearing tree mkd. by Ramsey in 1962

A burned Douglas-fir stump, size indeterminate,  
bears N. 62° W., 38.9 ft. dist., with no  
visible blaze.

and from which a new bearing tree

A Douglas-fir, 12 ins. diam., bears N. 65½° W.,  
52.6 ft. dist., mkd. T33S R4W S32 BT.

Cor. falls on east edge of a cut bank of a Jeep trail,  
8 ft. wide, extends generally N. and S.

Cor. of secs. 5, 6, 7, and 8. Monumented with an Iron  
post, 2½ ins. diam., firmly set, protruding 4 ins. above  
the ground, with 2 3/4 ins. diam. brass cap mkd.

T34S R4W  
S 6 | S 5  
S 7 | S 8  
1965

from which the remains of the original bearing trees

A Douglas-fir, 34 ins. diam., bears N. 51° E.,  
27.1 ft. dist., with healed blaze.

A Douglas-fir, 23 ins. diam., bears S. 79° W.,  
14.5 ft. dist., with fragmentary scribe marks  
visible on partially healed blaze.

A sawed, burned pine stump, 40 ins. diam.,  
bears N. 15° W., 27.1 ft. dist., with no  
visible blaze.

and from which bearing tree mkd. by Aanrud in 1965

A Douglas-fir, 10 ins. diam., bears S. 21½° E.,  
64.7 ft. dist., with healed blaze.

## CHAINS

Record of Evidence found: T. 34 S., R. 4 W., Sec. 5.

Cor. of secs. 4, 5, 8, and 9. Monumented with an iron post, 2½ ins. diam., firmly set, protruding 6 ins. above the ground, with 2 ¾ ins. diam. brass cap mkd.

T34S R4W	
S 5	S 4
S 8	S 9
1958	

from which the remains of the original bearing trees

A fir, 32 ins. diam., bears S. 65° E.,  
18.5 ft. dist., with open and burned blaze.

A burned fir stump, size indeterminate,  
bears S. 48° W., 46.9 ft. dist., with open  
and burned out blaze.

and from which the remains of the bearing trees mkd.  
by C. A. White in 1958

A cedar, 28 ins. diam., bears S. 83½° E.,  
46.2 ft. dist., with healed, burned blaze.

A burned cedar stump, size indeterminate,  
bears S. 25° W., 96.4 ft. dist., with scribe  
marks 4S R4W S8 BT visible on open face.

A madrone, (Record, laurel), 20 ins. diam.,  
bears N. 51° W., 94.0 ft. dist., with  
fragmentary scribing visible on partially  
healed, burned blaze.

The ¼ sec. cor. of secs. 4 and 5. Monumented with an  
iron post, 2½ ins. diam., firmly set, protruding 6 ins.  
above the ground, with 2 ¾ ins. diam. brass cap mkd.

T34S R4W	
¼	
S 5	S 4
1965	

from which the remains of the original bearing trees

A Douglas-fir snag, 15 ins. diam., bears S. 50° E.,  
37.0 ft. dist., with open and burned blaze.

A sawed Douglas-fir stump, 23 ins. diam.,  
bears S. 59° W., 38.3 ft. dist., with open  
and burned blaze.

and from which a bearing tree mkd. by Aanrud in 1965

A Douglas-fir, 10 ins. diam., bears N. 25° W.,  
89.8 ft. dist., with burned, healed blaze.

Cor. falls on N. slope, at the top of a cut bank of  
a dirt road, 10 ft. wide, extends E. and S. 45° W.

PROFESSIONAL  
LAND SURVEYOR

*Terrence O. Nickerson*

OREGON  
JULY 14, 1978  
TERRENCE O. NICKERSON  
(formerly 4-1844) USDI—BLM

1650

Survey Narrative to comply with O.R.S. 209.250

Dependent Resurvey of a Portion of the Subdivisional lines and the Survey of Section 5, T. 34 S., R. 4 W., Willamette Meridian, Jackson County, Oregon.

Surveyed By: Terrence C. Nickerson-O.R.L.S. 1649

For: U.S. Bureau of Land Management  
Medford District Office  
310 W. Sixth Street  
Medford, Oregon

Purpose: To delineate U.S. administered lands from private land.

Procedure: Beginning at the sec. cor. of secs. 4, 5, 8 and 9, T. 34 S., R. 4 W., I surveyed the lines and set the monuments as shown of the attached plat.

Special Notes:

1. At the  $\frac{1}{4}$  sec. cor. of secs. 5 and 6 I find no evidence of the original cor. I find a 1 ins. diam. iron pipe, firmly set, protruding 4 ins. above the ground, for which there is no known record. As this position falls within acceptable Manual of Surveying Instructions, 1973 limits, I accept it as a faithful and accurate reestablishment of the corner position by persons unknown. *no evidence seen*
2. At the  $\frac{1}{4}$  sec. cor. of secs. 5 and 8 of the original cor. or the bearing trees mkd. by the county surveyor in 1916. The area is in the middle of the area known as the Grave Creek Fire and falls in a dirt road. Numerous trees with apparent blazed faces were inspected, but no concrete evidence could be found. The corner position was therefor determined by proportionate methods.

Instruments used for this survey were a Wilde T16D theodolite, an HP 3205A electronic distance measuring device and a 66 foot steel tape. The bearings were based on an altitude observation of the sun and carried forward by sustained angulation. The field assistants were T.K. Rightor and James J. White.

