

CERTIFIED RECORD OF CORNER PERPETUATION

This corner was originally established by Rufus Moore in 1883 and subsequently re-established by Hans W. Thielsen in 1955 from the original record of Moore.

T325, R1W, W.M.

510 | 511
515 | 514


I find a 2 inch outside diameter iron pipe, firmly set with a brass cap attached, from which the bearing trees recorded by Thielsen were found as follows:

- A dead and down Hemlock with scribe visible, the root depression of which bears record N $4\frac{1}{2}^{\circ}$ W 53.5 ft.
- A Douglas Fir 24" diam. with healed blaze bears N $83\frac{1}{2}^{\circ}$ E 51.7 ft. (record N $83\frac{1}{2}^{\circ}$ E 52.8 ft.)
- A Hemlock, dead and standing with unhealed blaze and scribe visible bears S 41° E. 33.7 ft. (record S 41° E.35 ft.)
- A Hemlock, dead and standing with scribe visible in unhealed blaze bears S $74\frac{1}{2}^{\circ}$ W 63.7 ft. (record S $74\frac{1}{2}^{\circ}$ W 64 ft.)


I perpetuate the corner position by taking the following new bearing trees and place a brass washer bearing my registration No. in the lower blaze:

- A Douglas Fir 6 inch diam. marked "T32S R1W S10 BT" bears N 30° W 8.6 ft.
- A Hemlock 6 inch diam. marked "T32S R1W S 14 BT" bears S $17\frac{1}{2}^{\circ}$ E. 12.3 ft.
- A Douglas Fir 6 inch diam. marked "T32S R1W S 15 BT" bears S $38\frac{1}{2}^{\circ}$ W. 20.9 ft.

Va. = 23°

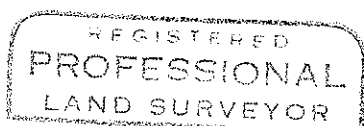

Kurt C. Weaver

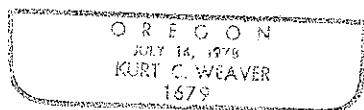

I hereby certify the above corner perpetuated as herein described on November 17, 1978.

Witnesses:

Herb Farber
Reg Harding

Office of Surveyor County of Jackson, State of Oregon, I hereby certify that the within instrument was filed in this office for record on 7TH day of DEC, 1978.

Howard A. M. Tandy by *James Brown*
County Surveyor Deputy

