

MAP OF SURVEY

LOCATED IN THE S.E. 1/4 OF THE S.W. 1/4 OF SECTION 15 AND THE N.E. 1/4 OF THE N.W. 1/4 OF SECTION 22, T 36 S, R 4 W, W. M., JACKSON COUNTY, OREGON.

FOR

DICK HANDBURY

BASIS OF BEARING: SURVEY No. 6934
O SET 5/8" X 30" IRON PIN
Ø SET 5/8" X 24" IRON PIN
● FD. 5/8" IRON PIN
SCALE: 1" = 100'
DATE: DECEMBER 20, 1978

REGISTERED
PROFESSIONAL
LAND SURVEYOR

Kurt C Weaver

OREGON
JULY 14, 1978
KURT C WEAVER
1679

JACKSON COUNTY
RECEIVED
DEC 28 1978
SURVEYOR

Survey No. 7549

SURVEY NARRATIVE TO COMPLY WITH O.R.S. 209.250.

Survey For: Mr. Dick Handbury
1001 West Evans Creek Road
Rogue River, Oregon 97537


Location: Located in the Southwest $\frac{1}{4}$ of Section 15, and
the Northwest $\frac{1}{4}$ of Section 22, Township 36
South, Range 4 West, Willamette Meridian,
Jackson County, Oregon.

Purpose: To monument the property owned by Mr. Handbury.

Procedure: The monuments were set in positions determined
from previously filed survey number 6934. Said
survey was quite extensive and should be re-
ferred to for information concerning the North,
East and West lines of Volume 245, Page 407 of
deed records.
The small parcel of land in the Southeast corner
is an exception from Mr. Handbury's deed and
was monumented accordingly. It is based on the
deed property line together with that portion of
land lying between same and the boundary line
agreement which is of record.

Surveyed By: T. Flatebo and Associates
P.O. Box 900
Jacksonville, Oregon 97530

Date: December 20, 1978

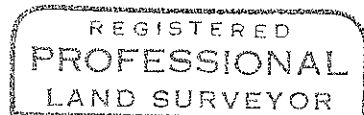

Kurt C. Weaver

