

7589

SURVEY FOR:

CALIFORNIA OREGON BROADCASTING INC.

AND

PACIFIC TELETRONICS, INC.

LOCATED IN BLOCK 6, CARLTON'S ADD'N.  
and IN BLOCK 2 OF ORCHARD ADD'N.  
IN D.L.C. No. 44, IN THE NORTH-HALF OF  
SEC. 31, T. 37 S. R. 1 W, W.M.

BY: MARK E. BOYDEN

Survey commenced April 30, 1976

Survey completed Jan. 9, 1979


ORIG.  $\odot$  MELROSE AVE.



SCALE 1"=50'

BASIS OF BEARINGS  
RECORDED SURVEY No. 6314

- $\odot$  FOUND 5/8" I. PIN FLUSH
- $\circ$  FOUND 3/4" I. PIN FLUSH
- $\bullet$  SET 3/4" x 24" I. PIN FLUSH UNLESS OTHERWISE INDICATED
- $\odot$  FOUND CONC. MON./BR. DISK IN MON. CASE

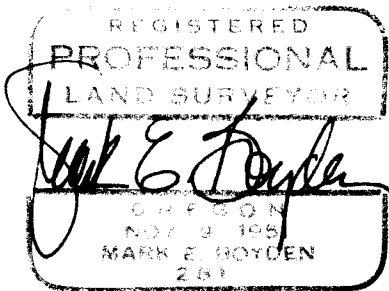

EAST STEWART AVE. 303.90'  
S 89° 59' 20" E  
SOUTH BDRY. ORCHARD ADD'N  
(Per R.S. No. 1055)

(TL.1200) S31BA 37 1W 7589

F. 2

Survey No. 7589

SURVEY NARRATIVE TO COMPLY WITH O.R.S. 209.250

FOR: California Oregon Broadcasting, Inc.  
& Pacific Teletronics, Inc.  
c/o KOBI - Television 5M  
2000 Crater Lake Highway  
Medford, Oregon

PURPOSE: 1. To monument the corners of Lot 6, Block 6 of  
CARLTON'S ADDITION (Recorded) for California Oregon  
Broadcasting, Inc.

2. To monument the corners of Lot 6, Block 2 of  
ORCHARD ADDITION (Recorded) for Pacific Teletronics,  
Inc., both being located in the North-half of Section  
31, T37SR1W, W.M., Medford, Oregon.

PROCEDURE: Using the controls previously utilized on Recorded  
Survey No. 6314, proportioned the additional lot  
corner positions and monumented same as shown on the  
annexed map.

January 9, 1979

