
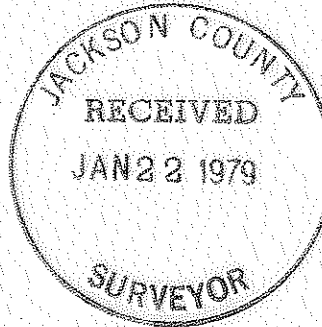


MAP OF SURVEY  
 LOCATED IN  
 S.W. 1/4 of Sec. 20, T37S, R1W, W.M.  
 JACKSON COUNTY, OREGON  
 FOR  
**JOSEPH O'CONNOR**

HOFFBUHR SURVEYING, INC. MEDFORD, OREGON  
 BY: RICHARD L. BATH P.L.S. No. 1069  
 SCALE: 1"=100' JANUARY 4, 1979  
 BASIS OF BEARING R/S No. 6541  
 ○ = SET 5/8" x 24" IRON REINF. ROD  
 ● = FD. 5/8" IRON ROD  
 • = FD. NAIL  
 (76-059)  
 37 1W 20CC 8800

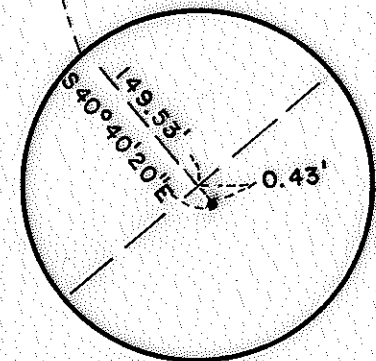

REGISTERED  
 PROFESSIONAL  
 LAND SURVEYOR  
*Richard L. Bath*  
 OREGON  
 JULY 30, 1974  
 RICHARD L. BATH  
 No. 1069

SURVEY NO. 7601

7601  
1092

SURVEY NARRATIVE TO COMPLY WITH PARAGRAPH 209.250  
OREGON REVISED STATUTES

SURVEY FOR: Joseph O'Connor  
516 Oregon Terrace  
Medford, Oregon 97501

LOCATION: Southwest one-quarter (1/4) of Section 20,  
Township 37 South, Range 1 West, Willamette  
Meridian, Jackson County, Oregon

PURPOSE: To survey and monument the boundary of Lot 1 in  
Block 2 of Eastwood Subdivision

PROCEDURE: Utilizing control established per Recorded Survey  
No. 1877 and 6541, set monuments as shown on attached map. Found  
monuments (origin unknown) at the most Westerly corners of Lots  
3 and 5 in Block 2. These monuments, found parallel to Lenora  
Drive, were used to control the Southeasterly boundary of Lot 1.  
Basis of bearing--Recorded Survey No. 6541

January 11, 1979

REGISTERED  
PROFESSIONAL  
LAND SURVEYOR  
*Richard L. Bath*  
OREGON  
JULY 30, 1976  
RICHARD L. BATH  
No. 1069

Richard L. Bath  
Hoffbuhr Surveying, Inc.

JACKSON COUNTY  
RECEIVED  
JAN 22 1979  
SURVEYOR