

Fd. 3/4" I. Pipe
in Mon. Case

Fd. I. Pipe
in Mon. Case

MAP OF SURVEY

located in
A portion of Lot 3, Blk. 12 in the City of Ashland
in SE 1/4 of Sec. 5, Twp. 39S., R. 1E.W.M.
Jackson County Oregon

AL CARVER

EVERETT L. SWAIN, R.P.L.S.

ASHLAND, OREGON

Scale: 1"=50'

July 31, 1978

Basis of Bearing: N.O.A.A. True Bearing @ sec. line for Sec. 4&5

- Found monument as shown
- Set 5/8 x 24 inch iron pin tagged RLS 759

SURVEY NO. 7620


SURVEY NARRATIVE TO COMPLY WITH PARAGRAPH 209.250
OREGON REVISED STATUTES

SURVEY FOR: Al Carver
378 Terrace Street
Ashland, Oregon 97520

LOCATION: Situated in a portion of Lot 3, Block 12 in the City of Ashland, Southeast quarter of Section 5, Township 39 South, Range 1 East of the Willamette Base and Meridian, Jackson County, Oregon.

PURPOSE: To survey, monument and prepare a legal description for a boundary line agreement exchange.

PROCEDURE: From previous control established by this office, established additional control in the vicinity of said proposed agreement line and then proceeded to monument said line as shown on the accompanying map.

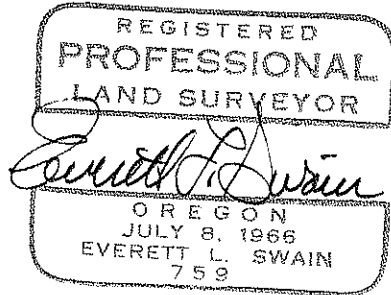

Everett L. Swain
Professional Land Surveyor
Ashland, Oregon

