


S 89°38'45" W  
1450.38'

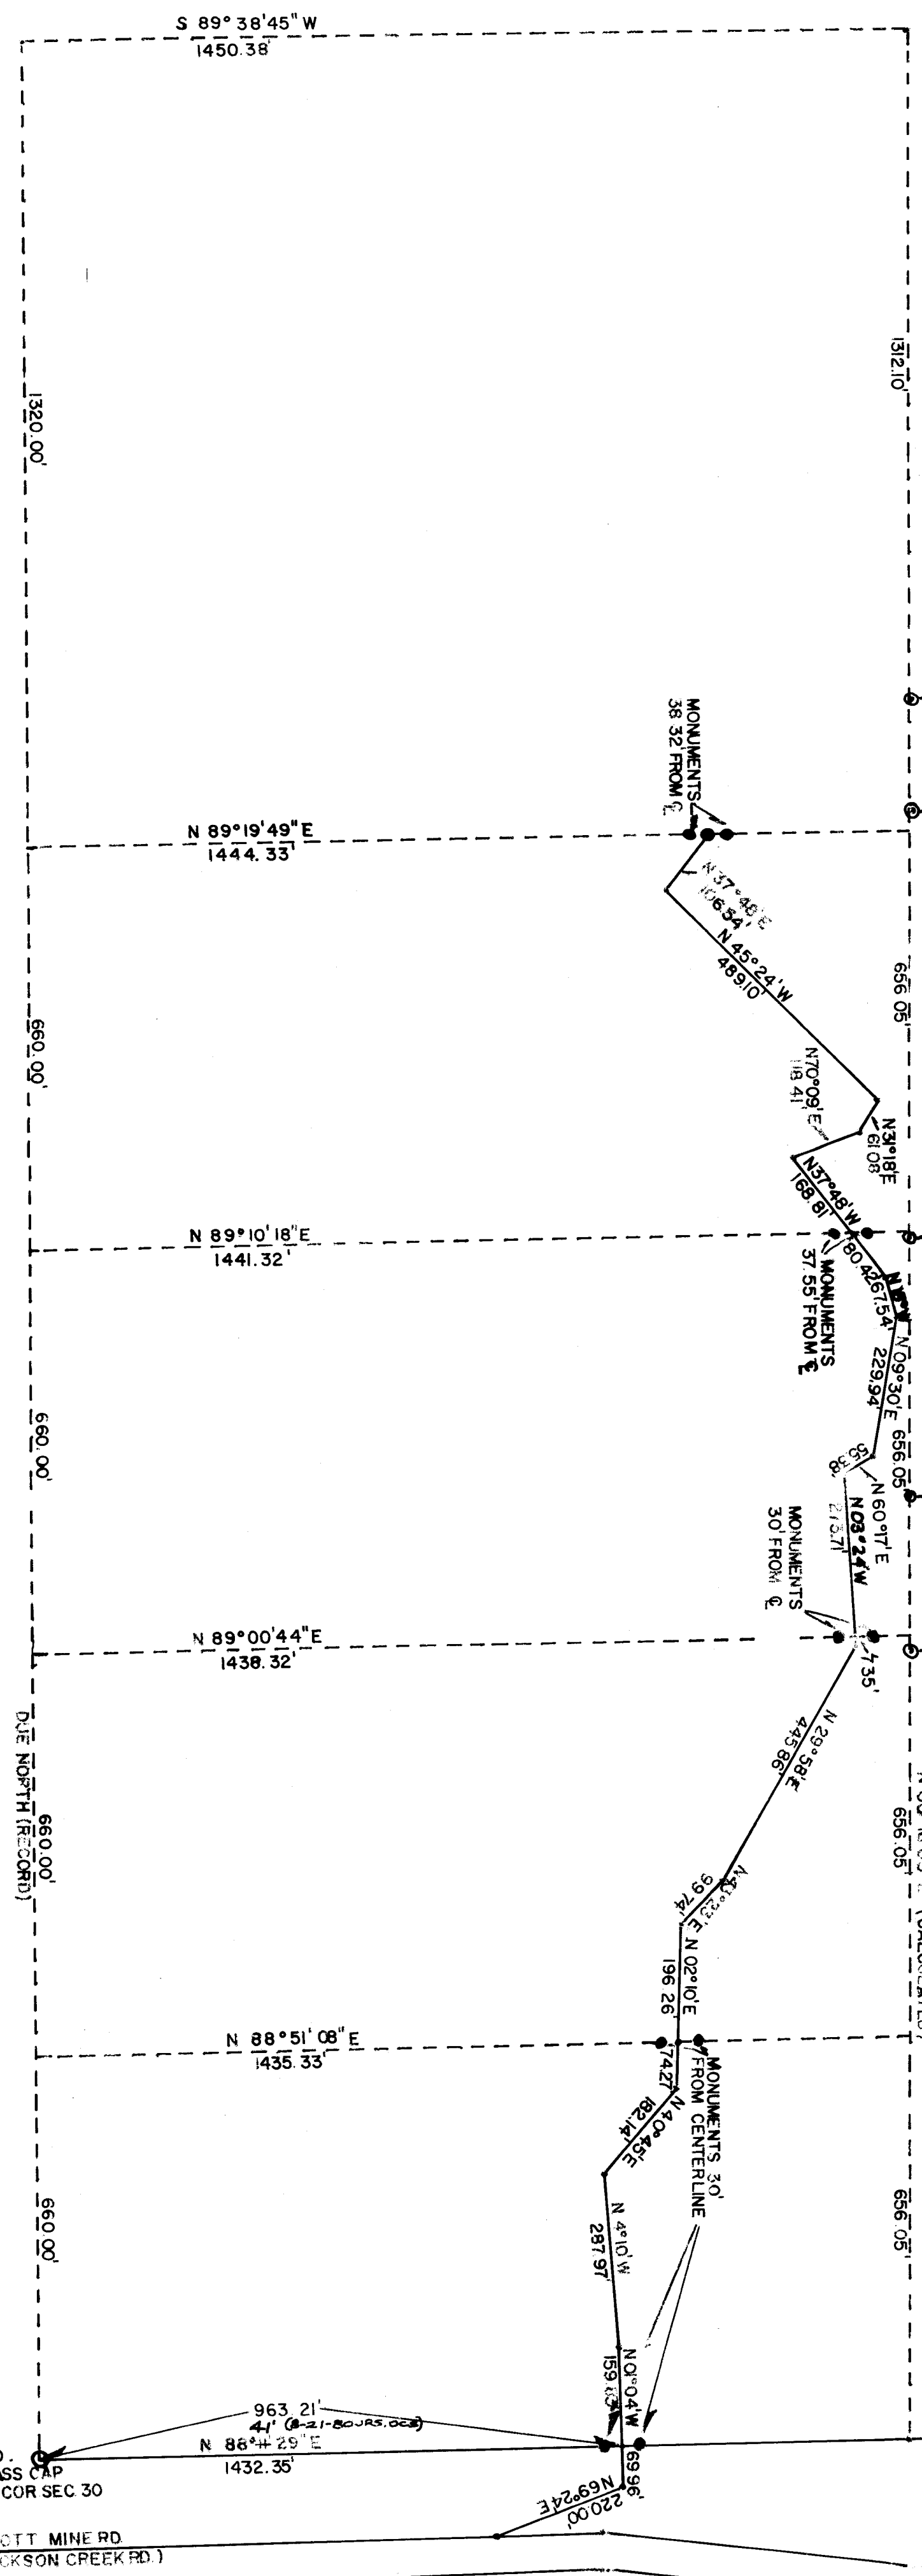



SCALE 1"=200'

MAP OF SURVEY  
FOR  
JOHN WINKLER


LOCATED IN SEC 30 & 31  
T 37 S, R 2 W.W.M  
JACKSON COUNTY, OREGON  
BY PHILIP B WICKHAM  
L S, ASHLAND, OREGON  
DECEMBER, 1978

BASIS OF BEARING: POLARIS OBSERVATION  
MAGNETIC VAR. 17° 30' E

- SET 5/8" X 24" IRON PIN
- ⊙ CORNERS FOUND

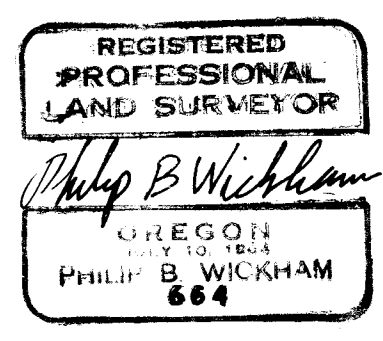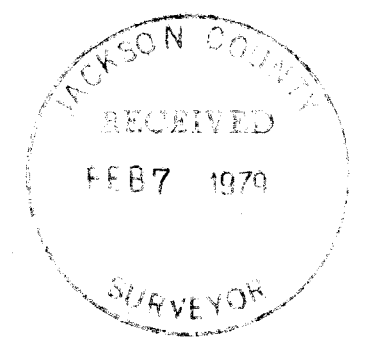

OTT MINE RD  
(JACKSON CREEK RD.)

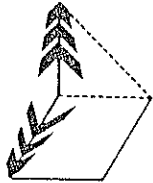

P.B. WICKHAM & ASSOCIATES  
OLD TOWN PROFESSIONAL BUILDING  
245 SOUTHWEST "G" STREET, SUITE A  
P.O. Box 564 • Grants Pass, Oregon 97526  
Bus. 503-476-6047  
Res. 503-474-0922

7627

PROFESSIONAL FORESTERS  
REGISTERED LAND SURVEYOR  
STRUCTURAL DESIGNER  
LOGGING CONTRACTORS

TIMBER INVENTORY, CRUISING & APPRAISALS  
LOGGING PLANS & SUPERVISION  
LAND PARTITIONS, WATER RIGHTS & R/W APPLICATIONS  
RECREATION & WATERSHED-FISHERIES FACILITIES  
TIMBER HARVESTING OR PURCHASE


County Surveyor  
Jackson County CT House  
Medford OR

Dear Sir

Please find enclosed a photo copy of a portion of the plat of recorded Survey # 7627 Dated Feb 7, 1979.

Please note bearing circled, which is incorrect as  $S\ N. 88^{\circ} 11' 29'' E.$  This bearing should be  $N 88^{\circ} 41' 29'' E.$  per my survey, calculations and original mapping. The error was made in lettering the final map. Would you please make the change on my recorded plat? Thank you

Sincerely,  
P.B. Wickham

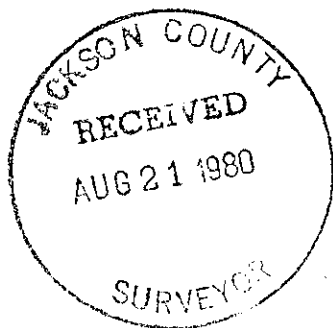

POSTED 8/21/80  
J.R. Swanson  
Deputy  
Put this letter in  
with narrative  
JRS

7627

I made a diligent search for the West 1/4 corner of section 30 after chaining between the Southwest and Northwest corners of section 30 and traversing to the projected location of the 1/4 corner (which point agreed with the chained location by 25 feet). Consequently, I believe that all evidence of this corner is lost.

Survey By: P. B. Wickham  
RLS No. 664  
P. O. Box 1674  
Medford, Oregon 97501

REGISTERED  
PROFESSIONAL  
LAND SURVEYOR

*Philip B. Wickham*

OREGON  
JULY 10, 1964  
PHILIP B. WICKHAM  
664

JACKSON COUNTY  
RECEIVED  
FEB 7 1979  
SURVEYOR

Survey Narrative to Comply with Paragraph 209-250  
Oregon Revised Statutes

Survey For: John Winkler  
P. O. Box 307  
St. Helens, Oregon 97051


Basis of Bearings: Polaris observation made during  
the course of the survey

Purpose of Survey: To provide mets and bounds des-  
cription and monumentation of an  
existing road.

Survey Procedure:

I located the re-established Southwest corner of section 30 and the re-established 1/4 corner between sections 30 and 31 and traversed between these corners to establish control for this survey; Also to determine if the fence and various monuments established along the fence-line on the East edge of my client's property would agree with the easterly lot line as projected from a proportioned location of the Southwest 1/16 corner. There was no significant variance. I also tied the road traverse to corners established along the fence-line by CS 3454 and 7045. There was no significant difference in the location of these corners in terms of the projected easterly lot boundary.

Having determined the road would be contained within the boundaries of my client's property, regardless of any changes that might result from a more detailed subdivision of the section, I proceeded to monument the extremities of the right-of-way at approximately 660-foot intervals (at the intersections of projected Government lot lines and projected division lines of the Government lots).

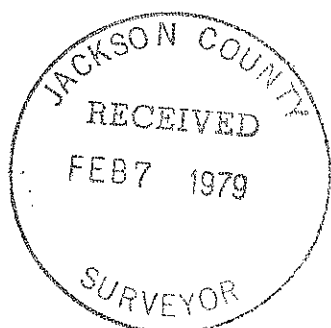

1441.32'

7627

MONUMENTS  
55' FROM C

N 09° 30' E  
229.94'

656.05'

MONUMENTS  
30' FROM C

N 60° 17' E  
N 03° 24' W  
273.71'

435'

N 00° 16' 03" E (CALCULATED)  
656.05'

N 29° 58' E  
443.86'

N 89° 00' 44" E  
1438.32'

99.74'

N 41° 22' E

N 02° 10' E

196.26'

742.7'

MONUMENTS 30'  
FROM CENTERLINE

N 40° 45' E  
182.14'

N 4° 10' W  
287.97'

N 0° 04' W  
159.83'

699.96'

N 69° 24' E  
220.00'

660.00'  
DUE NORTH (RECORD)

N 88° 51' 08" E  
1435.33'

656.05'

*In correct*

FD.  
BRASS CAP  
SW. COR. SEC. 30

OTT MINE RD.  
(JACKSON CREEK RD.)

N 88° 41' 29" E  
1432.35'

N 88° 41' 29" E  
1432.35'

*Correct*

JACKSON COUNTY  
RECEIVED  
AUG 21 1980  
SURVEYOR

7627