

SURVEY NO. 7663

SURVEY NARRATIVE TO COMPLY WITH PARAGRAPH 209-250 OREGON REVISED STATUTES.

SURVEY FOR: Jim Hughes
831 Savage Creek Road
Grants Pass, Oregon

LOCATION: Southwest 1/4 of Northwest 1/4 of Section 31,
T. 36 S., R. 4 W.W.M., Jackson County, Oregon.

PURPOSE: To survey 1.56 Acre tract out of larger parcel
and prepare description.

PROCEDURE: Found 5/8" iron rod and 1/2" iron pipes called
for in Document No. 78-10302. Made tie to West
Quarter corner. Found 1/2" iron pipes on East
line to be in old well established fence line.
Found 1/2" iron pipe to be 30' from existing
center line of Savage Creek Road and 1/2" iron
pin in existing center line. Used these points
for right of way control. Set new corners as
shown on attached plat.


BASIS OF BEARINGS: R.S. NO. 3897

Darrel W. Edwards
Rogue River, Oregon
Phone: 582-3110

REGISTERED
PROFESSIONAL
LAND SURVEYOR

Darrel W. Edwards

OREGON
JULY 8, 1966
DARREL W. EDWARDS
741

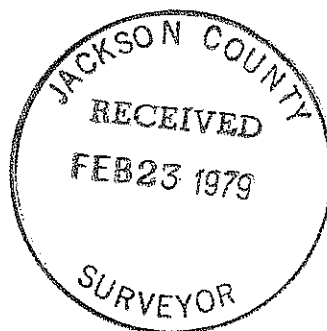

(T.L. 1800) 531 36 4W-7663