

*Spec for Book*

Corner Rehabilitation on the Josephine-Jackson County Line.

Survey executed at the Request of The Sunny Valley Lbr. Co.  
of Grants Pass, Oregon.

The point for cor. of secs. 19, 24, 25, and 30, on the W.  
bdy. of T. 34 S., R. 4 W., Willamette Mer., Oregon, is  
determined at the record bearing and distance from the  
only remaining bearing tree:

At the corner point,

Set an iron pipe, 3 ft. long, 2 ins. diam., 37 ins. in the  
ground, mkd. RS33; from which

A fir, 36 ins. diam., bears N.55°E., 37 lks. dist.,  
with partial scribe marks in charred old blaze.

And new bearing trees:



A Douglas fir, 36 ins. diam., bears S.68 $\frac{1}{2}$ °E., 215 lks.  
dist., mkd. T34S R4W S30 RS33 BT.

A Douglas fir, 40 ins. diam., bears S.40°W., 144 lks.  
dist., mkd. T34S R5W S25 RS33 BT.

A Douglas fir, 28 ins. diam., bears N.38 $\frac{1}{2}$ °W., 77 lks.  
dist., mkd. T34S R5W S24 RS33 BT.

This sec. cor. is located in center of a dirt road, bears  
N.75°W. and S.75°E.

Grants Pass, Oregon.  
August 6, 1953.

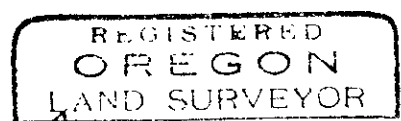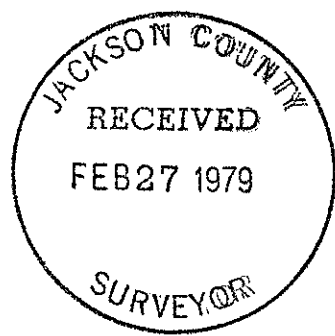

*Norman D. Price*

