

Survey No.

7671

T. 33 S., R. 4 W.,  
Willamette Meridian, Oregon.

U. S. GOVERNMENT PRINTING OFFICE 023271

Corner Rehabilitation on the Josephine-Jackson  
County Line in Mineral Survey  
No. 923.

Spd  
Lef

The cor. of secs. 25, 30, 31, and 36, on W. bdy. of  
T. 33 S., R. 4 W., is determined at the record meas-  
urements from the original NE. and SW. bearing trees;  
all other record evidence of this cor. has been des-  
troyed by logging operations.

At the corner point, which falls beneath an uprooted  
Douglas fir, 42 ins. diam.,

Set an iron pipe, 3 ft. long, 2 ins. diam., 28 ins. in  
the ground, mkd. RS33; from which the extant original  
bearing trees:

An incense cedar, 30 ins. diam., bears N.43°E., 51  
lks. dist., mkd. T33S R4W S30 BT.

An incense cedar, 14 ins. diam., bears S.65½°W., 37  
lks. dist., mkd. T33S R5W S36 BT.

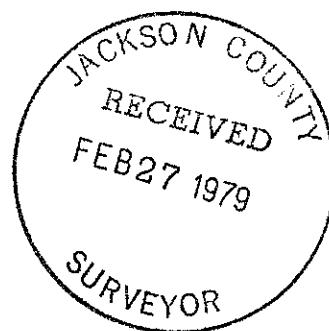
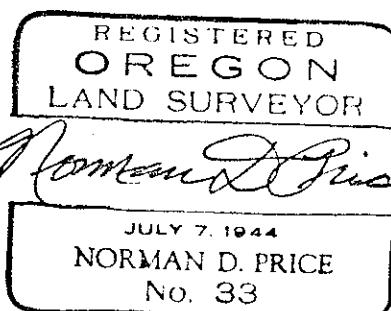
And new bearing trees:

An incense cedar, 8 ins. diam., bears S.68½°E., 78.7  
ft. dist., mkd. T33S R4W S31 RS33 BT.

A Douglas fir, 40 ins. diam., bears N.51½°W., 13.3  
ft. dist., mkd. T33S R5W S25 RS33 BT.

Grants Pass, Oregon.  
August 6, 1953.

*Norman D. Price*  
Norman D. Price,  
Mineral Surveyor.

7671