

LEGEND



O - SET 5/8" IRON PIN WITH PLASTIC CAP
STAMPED, FRIAR PLS 961

PLAT OF SURVEY

FOR

MRS. THEODORE GUETZLAFF

LOCATED IN SECTIONS 21 & 22,
TOWNSHIP 37 SOUTH, RANGE 1 WEST, W.M.
JACKSON CO. OREGON
SCALE: 1" = 200' DATE: DEC. 1978
BASIS OF BEARING: SURVEY NO. 5869
FRIAR - MOFFIT SURVEYING CO.
MEDFORD, OREGON

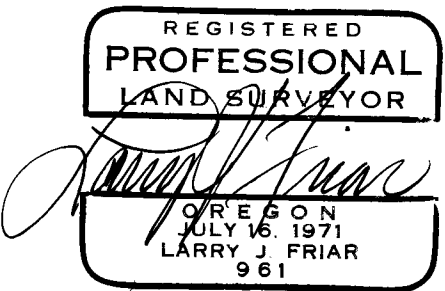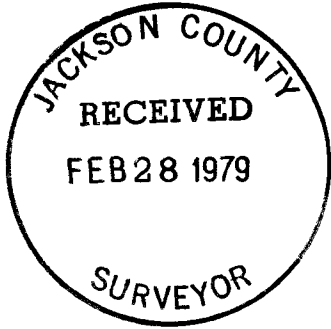

SURVEY NARRATIVE TO COMPLY WITH O.R.S. 209.250

SURVEY FOR: MRS. THEODORE GUETZLAFF
4195 RACHEL WAY
MEDFORD, OREGON 97501

LOCATION: THE N.E. 1/4 OF SECTION 21 AND THE
N.W. 1/4 OF SECTION 22, TOWNSHIP 37
SOUTH, RANGE 1 WEST, W.M., JACKSON
CO., OREGON.

PURPOSE: TO SURVEY AND MONUMENT A 22.30 ACRE
TRACT OF LAND.

PROCEDURE: USING FOUND MONUMENTS, AS SHOWN ON
THE ATTACHED MAP, FOR CONTROL THE
TRACT WAS LAID OUT AND MONUMENTED
AS SHOWN.

THE CONTROLLING TRAVERSE WORK WAS
DONE WITH ELECTRONIC MEASURING
EQUIPMENT.

DATE: FEBRUARY 7, 1979

L.J. FRIAR
FRIAR-MOFFIT SURVEYING CO.

