

7697

2692

SURVEY FOR HAROLD MUNSON


Lots 13 & 14, Block I
Thunderbird Heights Subdivision
S. W. 1/4 Sec. 5, T. 39 S., R. 1 E., W. M.
City of Ashland, Jackson County, Oregon
February 15, 1979



REGISTERED
PROFESSIONAL
LAND SURVEYOR

Verlyn D. Thomas

OREGON
MAY 13, 1960
VERLYN D. THOMAS
505

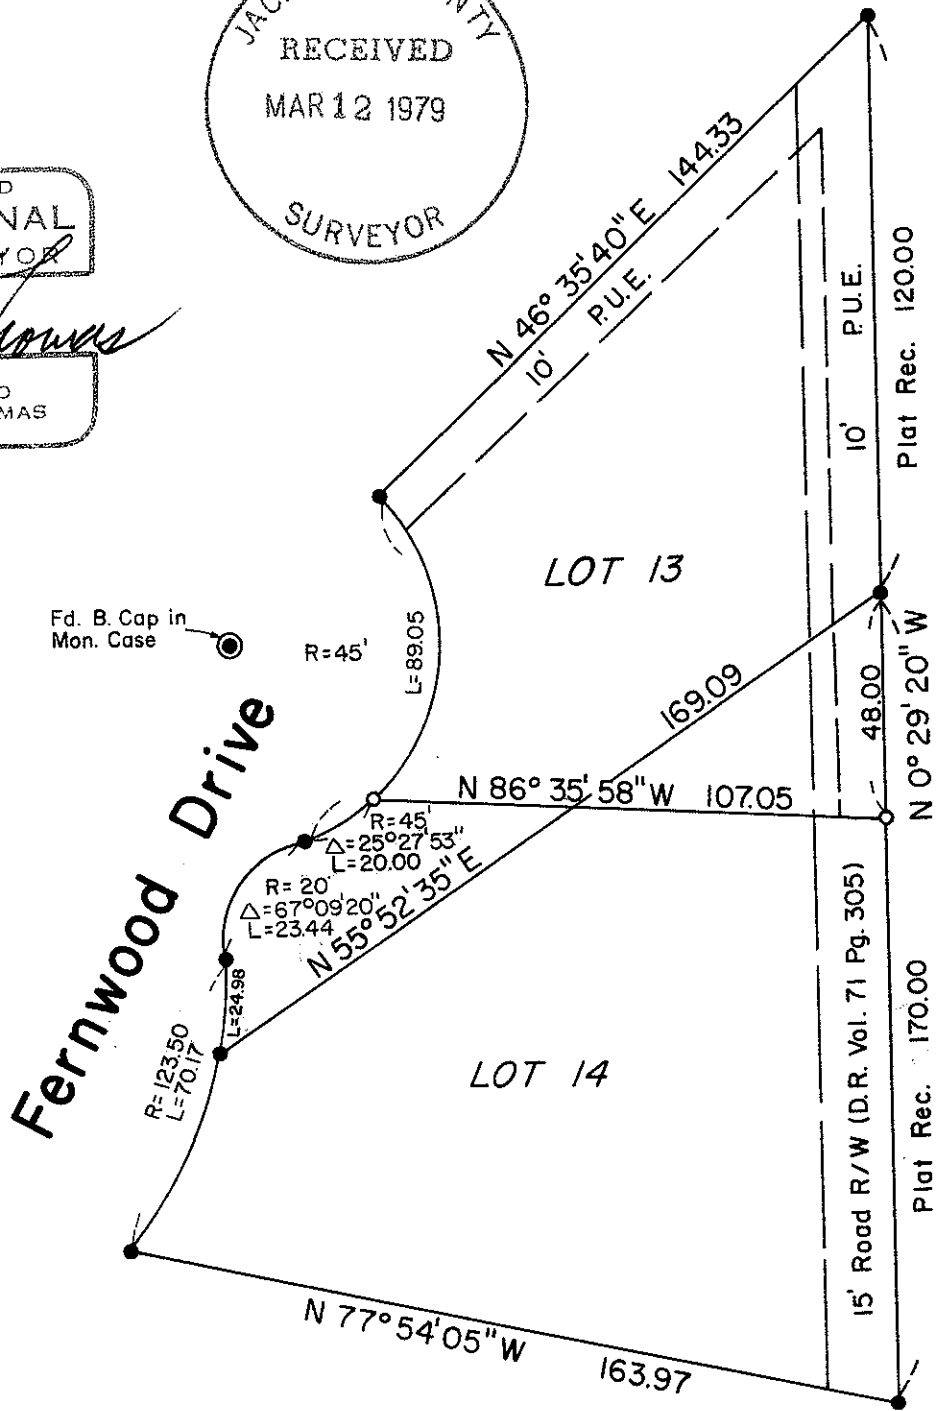

SCALE: 1" = 40'

LEGEND

- Mon. Fd., Per Record
- Set 5/8" X 24" I. Pin

BASIS OF BEARINGS: Thunderbird Heights Subdivision Plat.

7697

SE 1/4 SW 1/4 S 39-1E

SURVEY NARRATIVE TO COMPLY WITH O.R.S. 209.250

SURVEY FOR: Harold Munson
86 Monterey Drive
Medford, Oregon

PURPOSE: To adjust the boundary between Lots 13 and 14,
Block 1 of THUNDERBIRD HEIGHTS SUBDIVISION in the
City of Ashland, to provide a more favorable access
into proposed residential construction.

PROCEDURE: Recovered original monuments of record, and mon-
umented new division line as shown on the accompany-
ing plat.

REGISTERED
PROFESSIONAL
LAND SURVEYOR

Verlyn D. Thomas

OREGON
MAY 13, 1960
VERLYN D. THOMAS
505

JACKSON COUNTY
RECEIVED
MAR 12 1979
SURVEYOR