

SISKIYOU COUNTY SURVEYS: (for copies contact Siskiyou County)

7707 - no tracing

7708 - no tracing

7709 - no tracing

7710 - no tracing

7712 - no tracing

7713 - no tracing

7714 - no tracing

7712

R9W 24/19 R8W	18" Shasta Red Fir N74 $\frac{1}{2}$ $^{\circ}$ E 16.00 ft.	(Sec. 19)
T48N	19" Shasta Red Fir N51 $^{\circ}$ W 21.30 ft.	(Sec. 24)
	(Dec. 19 $^{\circ}$ 30')	

Ctr. Sec. 19
 1/4 Cor.
 T48N R8W

5" White Fir S77 $\frac{1}{2}$ $^{\circ}$ E 17.20 ft.
8" White Fir S62-3/4 $^{\circ}$ W 8.60 ft.
(Dec. 19 $^{\circ}$ 30')

18/19
 T48N, R8W

16" Shasta Red Fir N21 $\frac{1}{2}$ $^{\circ}$ W, 13.00 ft.	(Sec. 18)
27" Shasta Red Fir S43 $^{\circ}$ E, 28.19 ft.	(Sec. 19)
(Dec. 19 $^{\circ}$ 30')	


6. All bearings determined by solar observation. All traverse points hubbed and tacked. Used 20" K&E transit and all traverse angles doubled to check within 20".

L. P. Lovejoy

 L. P. LOVEJOY

LFL:l

Licensed Land Surveyor
 License No. 2604
 Medford, Oregon

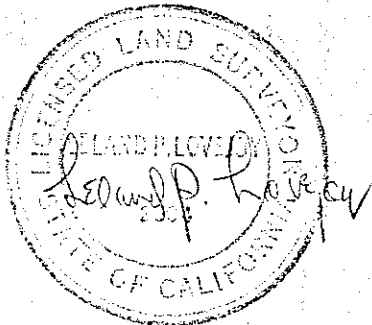

L. P. LOVEJOY
Registered Surveyor
1238 North Riverside Avenue
Medford, Oregon

October 12, 1954

7712

Mr. Albert F. Parrott
Surveyor for Siskiyou County, California
Yreka, California

Dear Sir:

We recently completed a survey for the Fruit Growers Supply Co.,
Hilt, California, for the purpose of subdividing Section 19,
Township 48 North, Range 8 West, Mt. Diablo Meridian, and cutting
out the Northwest Quarter.

The following procedure was followed:

1. The corner common to Sections 13 and 18, Township 48 North,
Range 8 and 9 West, Mt. Diablo Meridian, on State line, was
found. Also, the corner common to Sections 1, 6, 31, and 36,
Township 47 and 48 North, Range 8 and 9 West, Mt. Diablo
Meridian, was found. No intermediate corners could be found.
2. A traverse was run from corner common to said Sections 13 and 18,
to corner common to said Sections 1, 6, 31, and 36, on said
Township line, and measurement found to be short of record
measurement. The position of intermediate corners on the said
Township line were determined by single proportionate measurement.
3. The corners common to Sections 17, 18, 19, 20, and Sections 19,
20, 29, and 30, all in Township 48 North, Range 8 West, Mt. Diablo
Meridian, were found. No intermediate corners could be found.
A closed traverse was run around boundary of said Section 19,
with a total error of closure of 6.43 feet in a total of 4.769
miles of line, or a linear closure ratio of 1:3916.
4. Section 19 was subdivided on a single proportionate measurement
basis using record field notes and certified copy of Township Plat.
5. The following corners were set by driving a 1" galvanized pipe and
placing a mound of rock, with new witness trees blazed and tagged
with new yellow Department of Interior B.T. tags.

R9W	13 18	R8W	16" Shasta Red Fir bears N31° E 18.16 ft.	(Sec. 18)
	24 19		36" Shasta Red Fir S20 ¹ / ₂ ° E 16.83 ft.	(Sec. 19)
	TL8N		40" Shasta Red Fir S42° W 39.99 ft.	(Sec. 24)
			30" Shasta Red Fir N19-3/4° W 16.35 ft.	(Sec. 13)

(Dec. 19° 30')